IREDELL COUNTY HEALTH DEPARTMENT

STATESVILLE 704-878-5305 MOORESVILLE 704-664-5281

IMPROVEMENT PERMIT / AUTHORIZATION TO CONSTRUCT / OPERATION PERMIT / EXISTING SYSTEM INSPECTION

PERMIT# 117764 PIN# ~~4639462769.28~~ 4639-86-6312 DATE 4/2/04

OWNER OR CONTRACTOR HONEYSUCKLE CREEK LLC / Ingland Brown PHONE: Business 701-6465 Home

ADDRESS 227 HONEYSUCKLE CREEK LLC MOORESVILLE NC 28117

LOCATION PERTH (N) - TL 1st HONEYSUCKLE CK LOOP - ON LT.

SUBDIVISION HONEYSUCKLE CK. BLOCK / SECTION LOT 28 LOT AREA 1.054c SITE CLASS. PS DESIGN FLOW 480GPD L.T.A.R. ~.36GPD/FT²

Septic Tank: 1000 Gallons; STB 1007 Date 1-2-06

Pump Tank: 1000 Gallons; PT 274 Date 1-3-06

Pump Make Little Giant Model 9EH Serial No.

Nitrification Field: No Fields 1 Square Feet 580 Linear Feet 290

No Lines 6 Trench Width 24" Max Trench Bottom Depth 36" Gravel Depth N/A

☑ New System ☐ Repair System Type: I, II, III, IV, V, VI

System Description: LP PANEL

Repair System Description: SAME

Maintenance Agreement Required: ☑ Yes ☐ No

☑ House/Mod. Home No. Bedrooms 4

☐ Mobile Home No. Bathrooms 4

☐ Business No. Employees

☐ Other

☐ Slab ☐ Crawl Space ☑ Basement w/plumbing ☐ Basement wo/plumbing


Water Supply: ☑ Individual ☐ Public ☐ Community

Comments:/Conditions:


Comments:/Conditions Checked lines & tanks 2/27/06 MD

Checked pressure 3/6/06 MD

INITIAL SITE SKETCH 1" = 50'

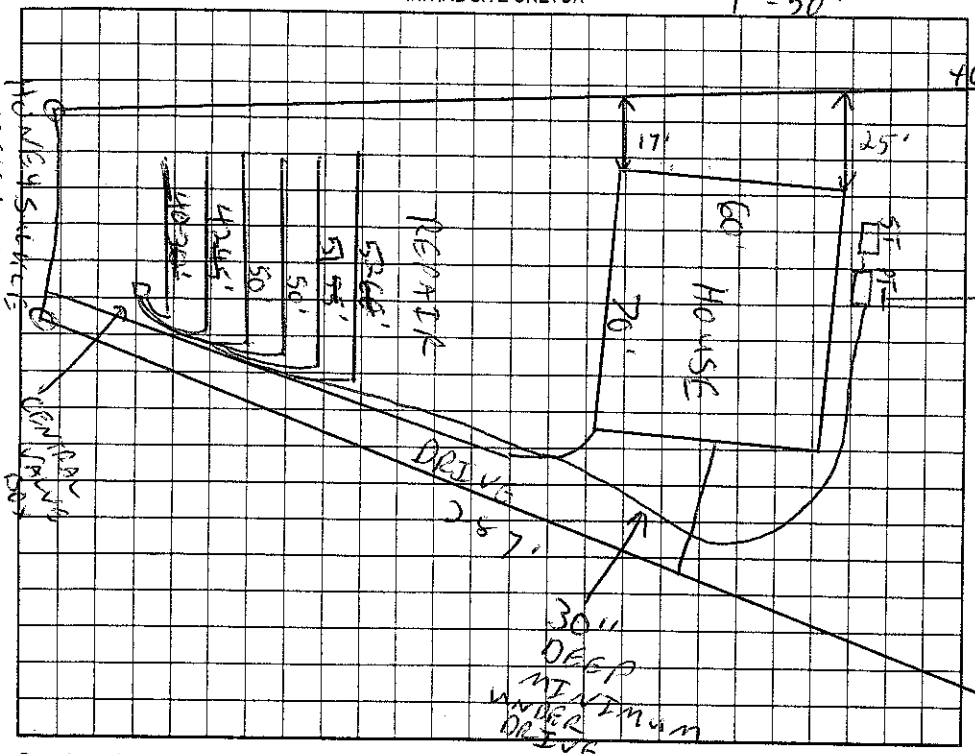

AS BUILT SKETCH

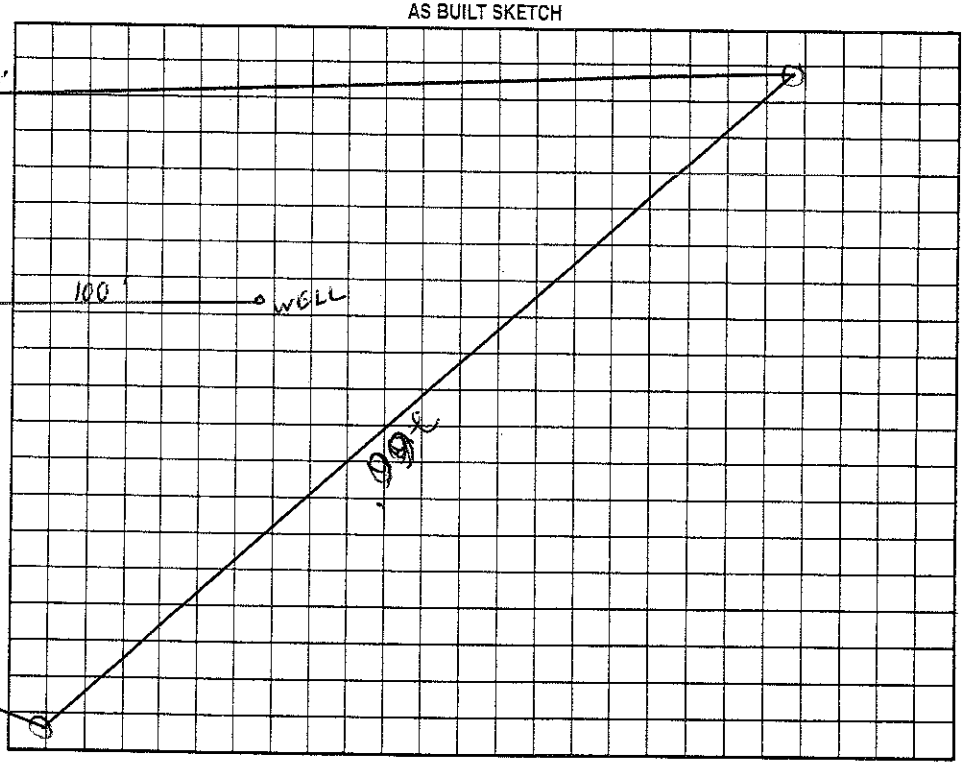

Permit can be suspended or revoked if any false information is supplied toward securing the permit/any unauthorized changes are made to the site/any unauthorized changes are made in the installation of the system. Improvement Permit with plat valid without expiration. Improvement Permit with site plan valid for sixty months. Authorization to Construct is valid for a period equal to that of Improvement Permit – not to exceed sixty months.

Signed: MRA date 7-28-04

Improvement Permit by: RS date 4/2/04

Authorization to Construct by: RS date 4/6/05

Installed by: Richard Abernathy

Operation Permit by: Maria H. Dotson RS date 4/4/06

Existing System Inspection by date

HEALTH DEPT. COPY: WHITE OWNER COPY (FINAL): YELLOW OWNER COPY (INITIAL): PINK