IREDELL COUNTY HEALTH DEPARTMENT

STATESVILLE 704-878-5305 MOORESVILLE 704-664-5281

IMPROVEMENT PERMIT / AUTHORIZATION TO CONSTRUCT / OPERATION PERMIT / EXISTING SYSTEM INSPECTION

PERMIT# 11763 PIN# 4639 96 2764.27 4639-86-6419 DATE 4/2/04

OWNER OR CONTRACTOR HONEYSUCKLE CREEK LLC/Regland-Brown PHONE: Business 201-6465 Home

ADDRESS 227 HIDEAWAY LN MOORESVILLE NC 28117

LOCATION PERTH (N) - JL 1st HONEYSUCKLE CK LOOP - ON LT

SUBDIVISION HONEYSUCKLE CREEK BLOCK / SECTION LOT 27 LOT AREA .71AC SITE CLASS. PS DESIGN FLOW 480GPD L.T.A.R. .360/E72

Septic Tank: 1000 Gallons; STB 1001 Date 12-2-05
Pump Tank: 1000 Gallons; PT 2714 Date 1-9-06
Pump Make: Little Giant Model 9EH Serial No 509350
Nitrification Field: No Fields 1 Square Feet 560 Linear Feet 280
No Lines ~~4~~ 5 Trench Width 24" Max Trench Bottom Depth 36" Gravel Depth N/A

☑ New System ☐ Repair System Type: I, II, III, IV, V, VI
System Description: LP PANEL
Repair System Description: SAME
Maintenance Agreement Required: ☑ Yes ☐ No

☑ House/Mod. Home No. Bedrooms 4
☐ Mobile Home No. Bathrooms 4
☐ Business No. Employees
☐ Other


☐ Slab ☐ Crawl Space ☑ Basement w/plumbing ☐ Basement wo/plumbing

Water Supply: ☑ Individual ☐ Public ☐ Community

Comments:/Conditions:

Comments:/Conditions: Installed 5 Panel lines Checked lines, tanks & pressure 2/27/06

INITIAL SITE SKETCH 1"=50'

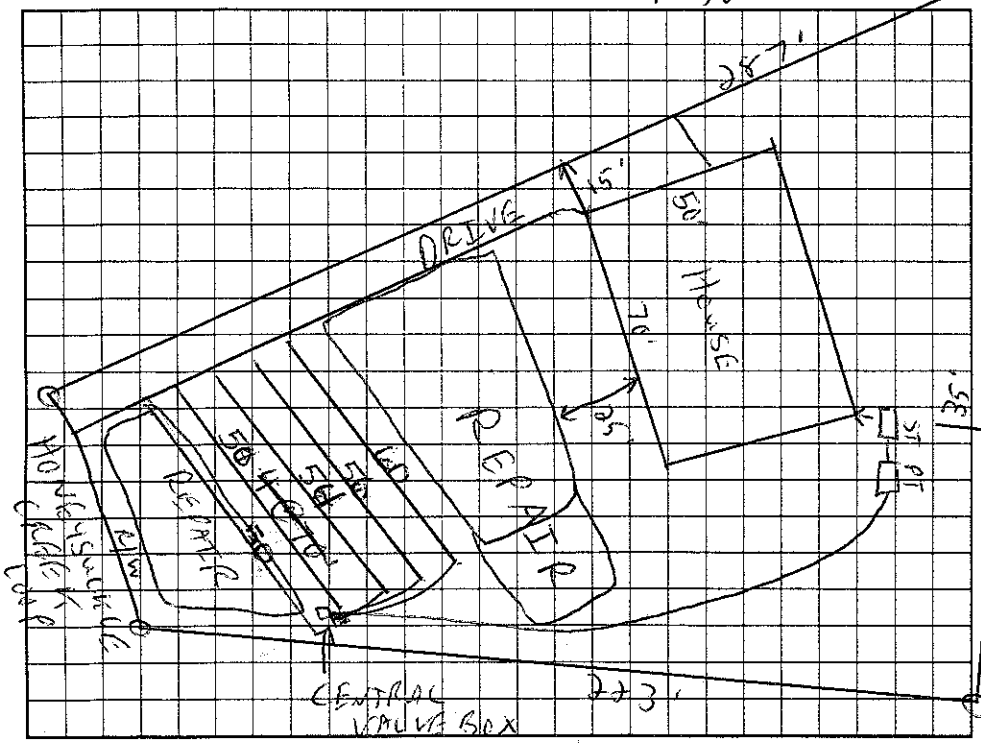

AS BUILT SKETCH

Permit can be suspended or revoked if any false information is supplied toward securing the permit/any unauthorized changes are made to the site/any unauthorized changes are made in the installation of the system. Improvement Permit with plat valid without expiration. Improvement Permit with site plan valid for sixty months. Authorization to Construct is valid for a period equal to that of Improvement Permit – not to exceed sixty months.

Signed: mrg date 7-28-04 Installed by: Richard Abernathy

Improvement Permit by: RS date 4/2/04 Operation Permit by: RS date 3/1/06

Authorization to Construct by: RS date 4/6/05 Existing System Inspection by: date

HEALTH DEPT. COPY: WHITE OWNER COPY (FINAL): YELLOW OWNER COPY (INITIAL): PINK