IREDELL COUNTY HEALTH DEPARTMENT

STATESVILLE 704-878-5305 MOORESVILLE 704-664-5281

IMPROVEMENT PERMIT / AUTHORIZATION TO CONSTRUCT / OPERATION PERMIT / EXISTING SYSTEM INSPECTION

PERMIT# 11776 PIN# 4639862976 9.26 4639866633 DATE 2-13-08

OWNER OR APPLICANT Honeysuckle Creek LLC / JM PHONE: Business 201-6465 Home

ADDRESS 227 Hideaway Ln Mooresville NC 28117 # 188

LOCATION Perth Rd N Rt 1st Honeysuckle on left

SUBDIVISION Honeysuckle Creek BLOCK / SECTION LOT 26 LOT AREA .64 Acre SITE CLASS PS DESIGN FLOW 450 gpd L.T.A.R. .25

Septic Tank: 1000 Gallons: STB 312 Date 1-31-08

Pump Tank: 1000 Gallons: PT 283 Date 4-15-08

Pump Make: Gouldş Model WE0712H2 Serial No.

Nitrification Field: No Fields 1 Square Feet 676' Linear Feet 338'

No Lines 8 Trench Width 24" min. Max Trench Bottom Depth 36" Gravel Depth N/A

☒ New System ☐ Repair ☐ Expansion System Type: I II III (IV) V VI

System Description: Pump-LP-Panel Blk

Repair System Description: Same

Maintenance Agreement Required: ☒ Yes ☐ No

☒ House/Mod. Home ☐ Mobile Home ☐ Business ☐ Other


No. Bedrooms 4 No. Persons No. Employees

Water Supply: ☒ Individual ☐ Public ☐ Community

☐ Gravity ☒ Pressure ☐ Slab ☐ Crawl Space ☐ Basement w/plumbing ☐ Basement wo/plumbing

Comments:/Conditions: Note: Install Panel Block drainlines 8 Ft on center - minimum Stay 15Ft side slope or 25ft upslope From basement.

INITIAL SITE SKETCH Scale 1:50

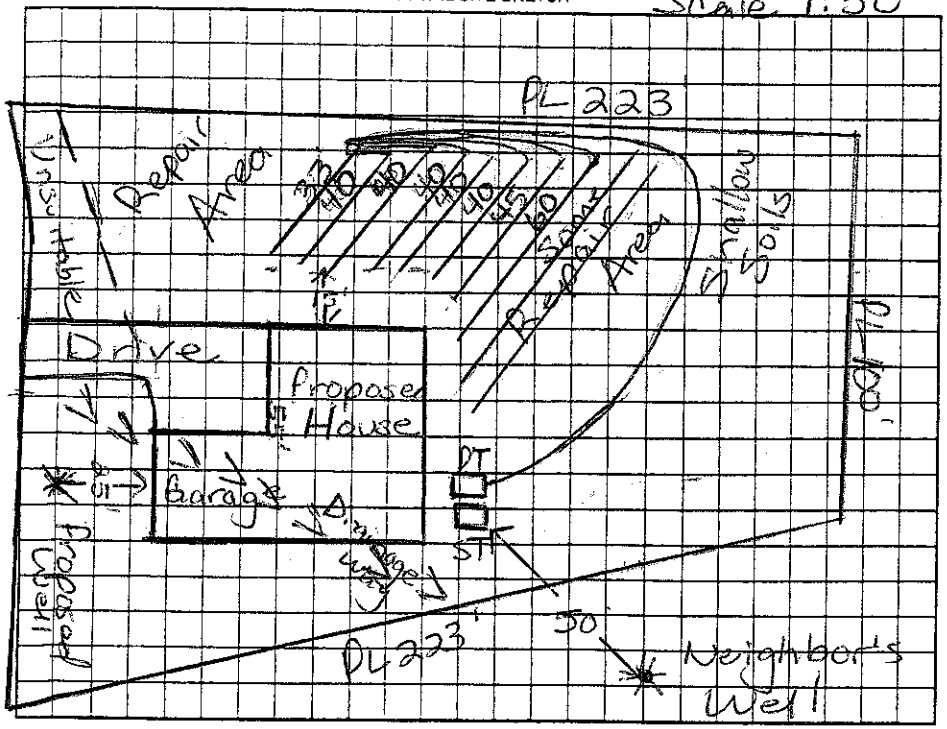

Comments:/Conditions: Keep Septic System at least 50ft from any well. Must use "in line" filter on PT. Checked tanks & last line 1/13/09

AS BUILT SKETCH

3/16" hole drilled

See Attached "As Built"

Honeysuckle Loop

Permit can be suspended or revoked if any false information is supplied toward securing the permit/any unauthorized changes are made to the site/any unauthorized changes are made in the installation of the system. Improvement Permit with plat valid without expiration ☐ Improvement Permit with site plan valid for sixty months ☐ Authorization to Construct is valid for a period equal to that of Improvement Permit – not to exceed sixty months.

Signed: date 2/13/08

Improvement Permit by: Mark Hoffman RS date 2/13/08

Authorization to Construct by: date 3-28-08

Installed by: C. Wayne Wrinkle RS

Operation Permit by: Mark Hoffman date 2/24/09

Existing System Inspection by: date

HEALTH DEPT. COPY: WHITE OWNER COPY (FINAL): YELLOW OWNER COPY (INITIAL): PINK