As Built Drawing

IREDELL COUNTY HEALTH DEPARTMENT

STATESVILLE 704-878-5305 MOORESVILLE 704-664-5281

IMPROVEMENT PERMIT / AUTHORIZATION TO CONSTRUCT / OPERATION PERMIT / EXISTING SYSTEM INSPECTION

PERMIT # 117761 PIN # 4639962769.26 DATE 1-20-09

OWNER or APPLICANT CJM Builders PHONE: Business Chris Mauch 634-4959 Home:

OWNER or APPLICANT ADDRESS

LOCATION / DIRECTIONS Perth Rd N TL 1st Honeysuckle on left

SUBDIVISION Honeysuckle Creek BLOCK / SECTION LOT # 26 LOT AREA .64Acre DESIGN FLOW 480gpd L.T.A.R. .25

Septic Tank 1000 Gallons: STB 312 Date 7-31-08
Pump Tank 1000 Gallons: PT 283 Date 9-15-08
Pump Make Goulds Model WE0712HU Serial #
Nitrification Field No Fields 1 No Lines 7 Linear Feet 332'*
Trench Width 24"min Max. Trench Bottom Depth 36"min Gravel Depth N/A

☒ New System ☐ Repair ☐ Expansion System Type I II III (IV) V VI
System Description: Pump-LP-Panel Blk
Repair System Description: Same
Maintenance Agreement Required ☒ YES ☐ NO
☐ GRAVITY ☒ PRESSURE


☒ Residence No. Bedrooms 4
☐ Business - No. Persons
☐ Other No. Employees
☐ Slab ☐ Crawl Space
☐ Basement w/plumbing ☐ Basement w/o plumbing

Water Supply: ☒ Private ☐ Public ☐ Community

Comments / Conditions * 320Ft min required Drainfield @ .25 LTAP

Scale 1:50'

INITIAL SITE SKETCH

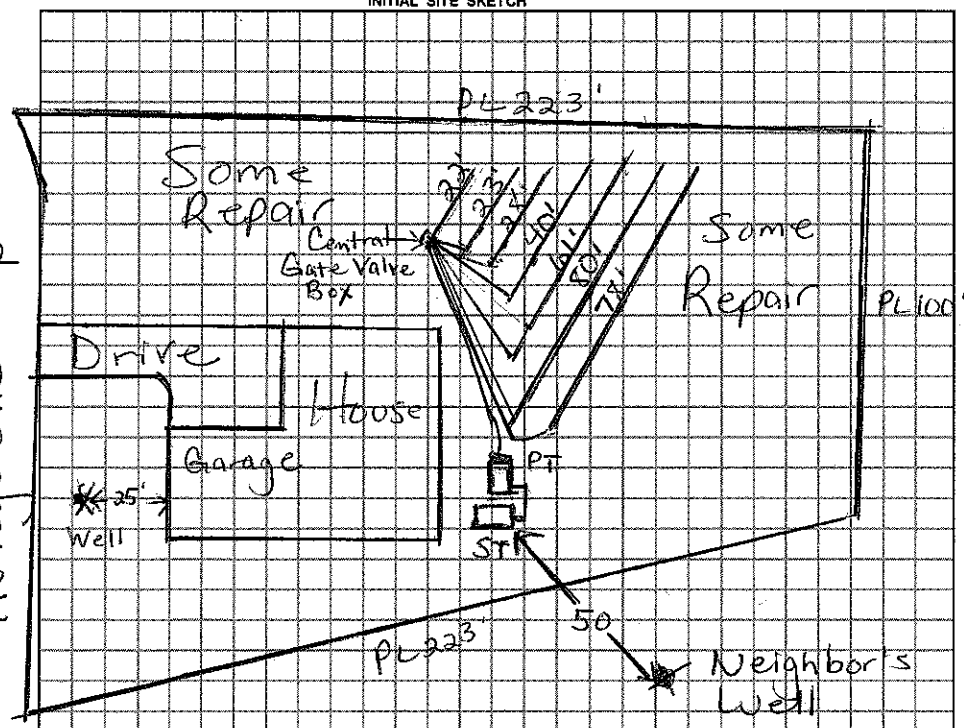

Comments / Conditions 3/16" hole drilled

Checked tanks ~~& test time~~ 1/13/09

AS BUILT SKETCH

Checked remaining drainlines & Set pressure 1/15/09

Permit can be suspended or revoked if any false information is supplied toward securing the permit / any unauthorized changes are made to the site / any unauthorized changes are made in the installation of the system.

☐ *IMPROVEMENT PERMIT w / plat valid without expiration.* ☐ *IMPROVEMENT PERMIT w / site plan valid for 60 mos.* ☐ *AUTHORIZATION TO CONSTRUCT valid for period equal to IMPROVEMENT PERMIT-not to exceed 60 mo.*

Owner / Applicant Signature: Date

Improvement Permit by: Maria H. Dotson Date 1/20/09

Authorization to Construct by: Maria H. Dotson Date 1/20/09

YOU SHOULD CONTACT A LOCATOR SERVICE PRIOR TO ANY EXCAVATION.

Installed by: C. Wayne Robinson RS

Operation Permit by: Maria H. Dotson RS Date: 2/24/09

Existing System Inspected by: Date:

WHITE COPY Environmental Health YELLOW COPY (Final) Owner / Applicant PINK COPY (Initial) Owner / Applicant