IREDELL COUNTY HEALTH DEPARTMENT

STATESVILLE 704-878-5305 MOORESVILLE 704-664-5281

IMPROVEMENT PERMIT / AUTHORIZATION TO CONSTRUCT / OPERATION PERMIT / EXISTING SYSTEM INSPECTION

PERMIT# 117803 PIN# ~~4639-96-2769-49~~ 4639-86-8661 DATE 7/22/14

OWNER OR CONTRACTOR HONEYSUCKLE CREEK LLC / Pride Homes PHONE: Business 201-6465 Home

ADDRESS 227 HIDEAWAY LANE MOORESVILLE NC 28117

LOCATION PERTH (N) - TL 1ST HONEYSUCKLE CREEK - ON RT IN CURVE

SUBDIVISION HONEYSUCKLE CREEK BLOCK / SECTION LOT 49 LOT AREA .63Ac SITE CLASS. PS DESIGN FLOW 480GPD L.T.A.R. .256 PD/Ac

Septic Tank: 1000 Gallons; STB 1012 Date 2/28/05
Pump Tank: 1000 Gallons; PT 17 Date 4/9/05
Pump Make: Goulds Model WE0311M Serial No.
Nitrification Field: No Fields 4 Square Feet 640 Linear Feet 320
No Lines 4 Trench Width 24" Max Trench Bottom Depth 30" Gravel Depth N/A

☑ New System ☐ Repair System Type: I, II, III, IV, V, VI
System Description: LP PANEL
Repair System Description: OFFSITE Pump 25% REDUCTION
Maintenance Agreement Required: ☑ Yes ☐ No


☑ House/Mod. Home No. Bedrooms 4
☐ Mobile Home No. Bathrooms 4
☐ Business No. Employees
☐ Other
☐ Slab ☑ Crawl Space ☐ Basement w/plumbing ☐ Basement wo/plumbing

Water Supply: ☑ Individual ☐ Public ☐ Community


Comments:/Conditions: * GULLIES TO BE FILLED AND PACKED WITH DEBRIS-FREE SOIL.
* SEE MASTER PLAT FOR OFFSITE SEPTIC REPAIR AREA LOCATION AND SUPPLY LINE.

Comments:/Conditions:
76 Panels 3/16" holes

INITIAL SITE SKETCH 1" = 50'

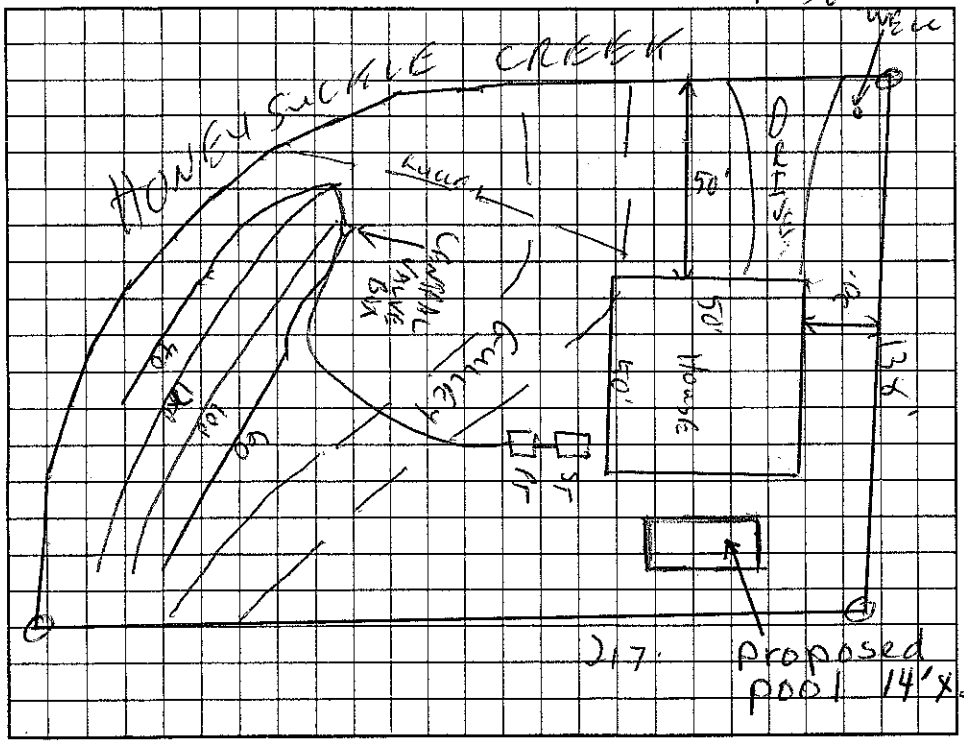

AS BUILT SKETCH

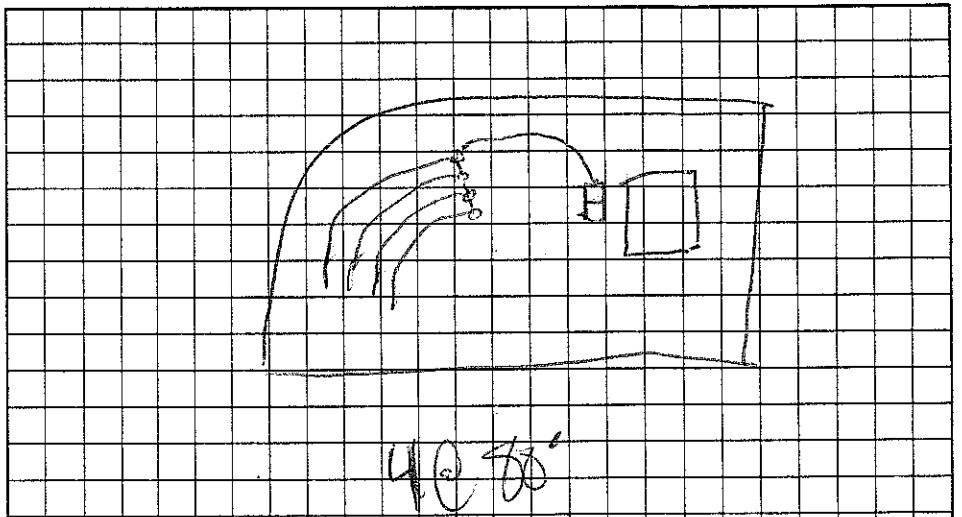

Location of the proposed Pool addition does not appear to impact the existing on-site septic system.**NOTE:
Judy Metcalf REHS
Date: 8-22-11
ICHD-Environmental Health Division

Permit can be suspended or revoked if any false information is supplied toward securing the permit/any unauthorized changes are made to the site/any unauthorized changes are made in the installation of the system. Improvement Permit with plat valid without expiration. Improvement Permit with site plan valid for sixty months. Authorization to Construct is valid for a period equal to that of Improvement Permit – not to exceed sixty months.

Signed: [signature] date 7-28-04 Installed by: C & S

Improvement Permit by: C. [signature] RS date 7/22/14 Operation Permit by: [signature] RS date 11/18/05

Authorization to Construct by: Wesley Sparks RS. date 5/4/05 Existing System Inspection by: date

HEALTH DEPT. COPY: WHITE OWNER COPY (FINAL): YELLOW OWNER COPY (INITIAL): PINK