IREDELL COUNTY HEALTH DEPARTMENT

STATESVILLE 704-878-5305 MOORESVILLE 704-664-5281

IMPROVEMENT PERMIT / AUTHORIZATION TO CONSTRUCT / OPERATION PERMIT / EXISTING SYSTEM INSPECTION

PERMIT# 117766 PIN# ~~4639962764.37~~ 4639-86-9138 DATE 4/2/04

OWNER OR CONTRACTOR HONEYSUCKLE CREEK LLC/Lewis Cerpen PHONE: Business 201-6465 Home

ADDRESS 227 HEDGEWAY LN MOORESVILLE NC 28117

LOCATION PERTH (N) - TL 1ST HONEYSUCKLE - ON LT.

SUBDIVISION HONEYSUCKLE CREEK BLOCK / SECTION LOT 31 LOT AREA .54AC SITE CLASS. PS DESIGN FLOW 480GPD L.T.A.R. .3650/F72

Septic Tank: 1000 Gallons; STB 312 Date 4/19/04

Pump Tank: 1000 Gallons; PT 27 Date 5/11/06

Pump Make: Goulds Model WE0724 Serial No.

Nitrification Field: No Fields 1 Square Feet 540 Linear Feet 270

No Lines 4@70' Trench Width 24" Max Trench Bottom Depth 36" Gravel Depth N/A

☑ New System ☐ Repair System Type: I, II, III, (IV), V, VI

System Description: LP PANEL

Repair System Description: SAME

Maintenance Agreement Required: ☑ Yes ☐ No

☑ House/Mod. Home No. Bedrooms 4

☐ Mobile Home No. Bathrooms 4

☐ Business No. Employees

☐ Other


☐ Slab ☐ Crawl Space ☑ Basement w/plumbing ☐ Basement wo/plumbing

Water Supply: ☑ Individual ☐ Public ☐ Community


Comments:/Conditions:

Comments:/Conditions:

INITIAL SITE SKETCH

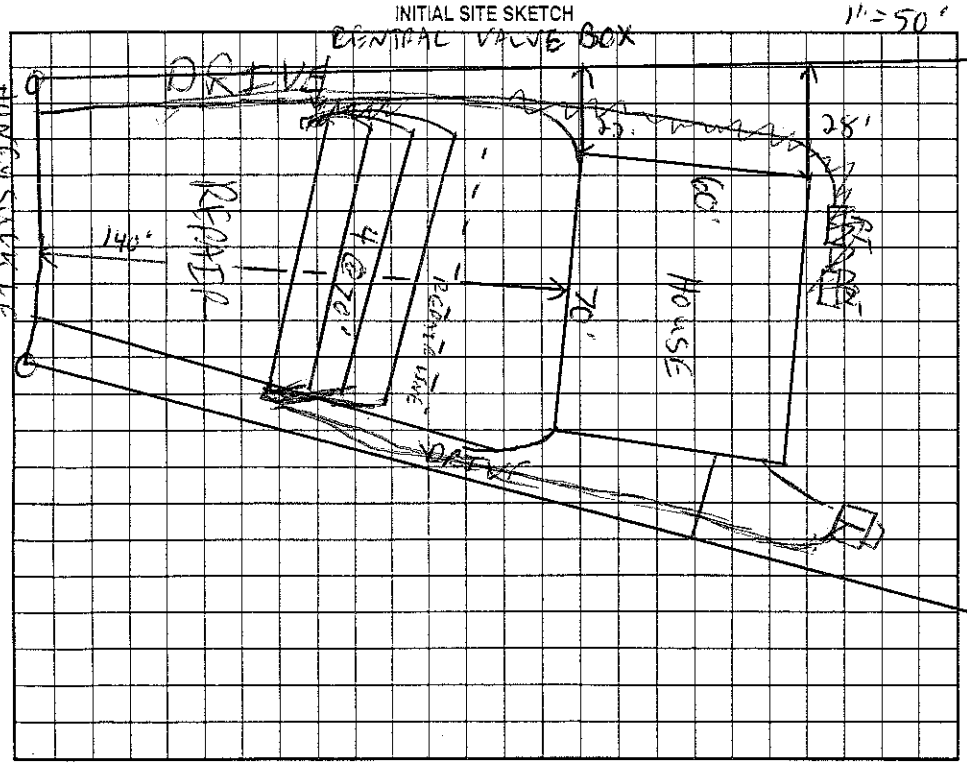

AS BUILT SKETCH

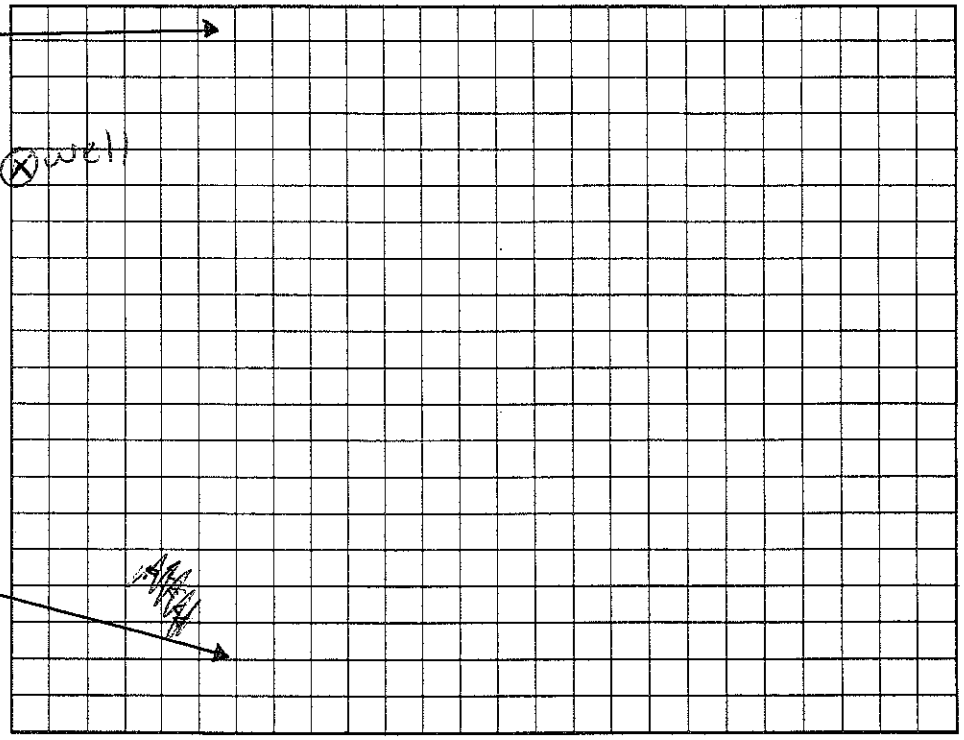

Permit can be suspended or revoked if any false information is supplied toward securing the permit/any unauthorized changes are made to the site/any unauthorized changes are made in the installation of the system. Improvement Permit with plat valid without expiration. Improvement Permit with site plan valid for sixty months. Authorization to Construct is valid for a period equal to that of Improvement Permit – not to exceed sixty months.

Signed: MRG date 7-28-04 Installed by: Larry Beam

Improvement Permit by: RS date 4/2/04 Operation Permit by: LS date 6/19/06

Authorization to Construct by: RS date 10/5/05 Existing System Inspection by: date

HEALTH DEPT. COPY: WHITE OWNER COPY (FINAL): YELLOW OWNER COPY (INITIAL): PINK