IREDELL COUNTY HEALTH DEPARTMENT

STATESVILLE 704-878-5305 MOORESVILLE 704-664-5281

IMPROVEMENT PERMIT / AUTHORIZATION TO CONSTRUCT / OPERATION PERMIT / EXISTING SYSTEM INSPECTION

PERMIT# 117785 PIN# ~~4639962769.000~~ 4639-86-9691 DATE 7/22/04

OWNER OR CONTRACTOR HONEYSUCKLE CREEK LLC / Lewis Carpenter PHONE: Business 701-6465 Home

ADDRESS 227 HIDEAWAY LANE MOORESVILLE NC 28117

LOCATION @ PERTH (N) - TL 1ST HONEYSUCKLE - ON RT

SUBDIVISION HONEYSUCKLE CREEK BLOCK / SECTION LOT 45 LOT AREA .6AC SITE CLASS. PS DESIGN FLOW 480GPD L.T.A.R. .3gal/ft2

Septic Tank: 1000 Gallons; STB 794 Date 11/3/05

Pump Tank: Gallons; PT Date

Pump Make: Model Serial No.

Nitrification Field: No Fields 1 Square Feet 560 Linear Feet 280

No Lines 8@35' Trench Width 24" Max Trench Bottom Depth 36" Gravel Depth N/A

☑ New System ☐ Repair System Type: I, II, III, IV, V, VI

System Description: GRAVITY PANEL

Repair System Description: LP PANEL

Maintenance Agreement Required: ☐ Yes ☑ No

☑ House/Mod. Home No. Bedrooms 4

☐ Mobile Home No. Bathrooms 4

☐ Business No. Employees

☐ Other

☐ Slab ☑ Crawl Space ☐ Basement w/plumbing ☐ Basement wo/plumbing


Water Supply: ☑ Individual ☐ Public ☐ Community

Comments:/Conditions: Reviewed plans, essentially in Compliance with original permit.

Comments:/Conditions:

INITIAL SITE SKETCH

1"=50'

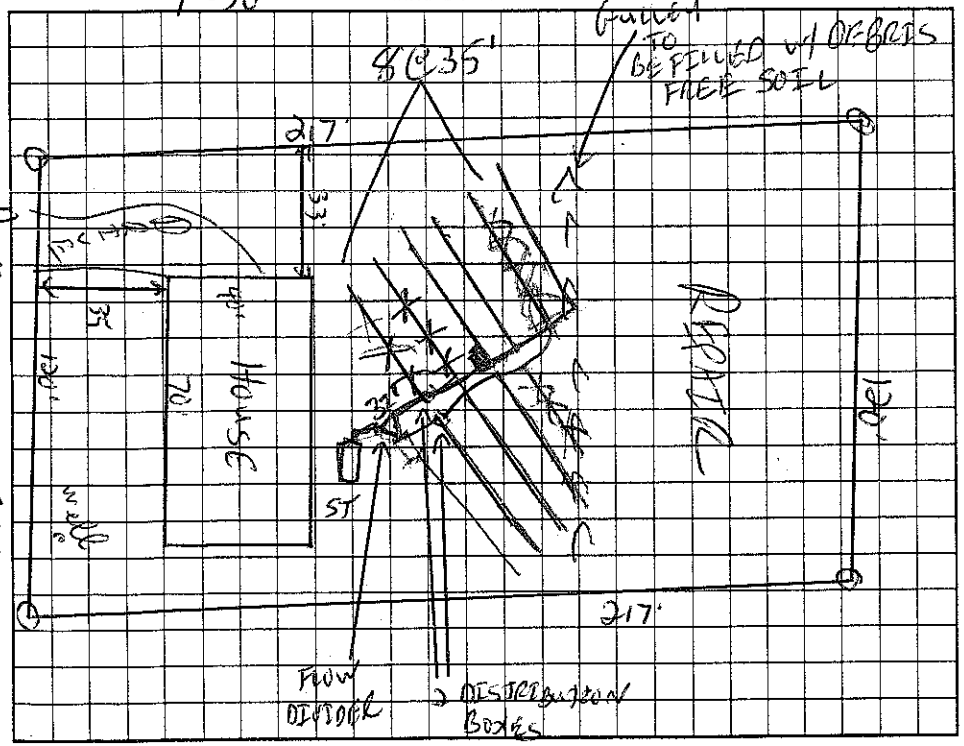

AS BUILT SKETCH

Permit can be suspended or revoked if any false information is supplied toward securing the permit/any unauthorized changes are made to the site/any unauthorized changes are made in the installation of the system. Improvement Permit with plat valid without expiration. Improvement Permit with site plan valid for sixty months. Authorization to Construct is valid for a period equal to that of Improvement Permit – not to exceed sixty months.

Signed: [signature] - mrq date 7-28-04 Installed by: Larry Brown

Improvement Permit by: [signature] RS date 7/22/04 Operation Permit by: Wesley Sparks RS. date 2/24/06

Authorization to Construct by: [signature] RS date 5/31/05 Existing System Inspection by: date

HEALTH DEPT. COPY: WHITE OWNER COPY (FINAL): YELLOW OWNER COPY (INITIAL): PINK