IREDELL COUNTY HEALTH DEPARTMENT

TESVILLE 704-878-5305 50.00 Paid 2.30 MOORESVILLE 704-664-5281

IMPROVEMENT PERMIT / AUTHORIZATION TO CONS[TRUCT] / OPERATION PERMIT / EXISTING SYSTEM INSPECTION

PERMIT# 116702 PIN# ~~4639462 764.10~~ 4639-86-9873 DATE 6/8/04

OWNER OR CONTRACTOR LAKEMONT HOMES PHONE: Business 400-2344 Home

ADDRESS PO BOX 1463 MATTHEWS NC 28105

LOCATION PARTH RD(S) - TL 2nd HONEYSUCKLE - ON LT

SUBDIVISION HONEYSUCKLE CK. BLOCK / SECTION LOT 10 LOT AREA .16AC SITE CLASS PS DESIGN FLOW 360GPD L.T.A.R. .25AR/FT2

Septic Tank: 1000 Gallons; STB 312 Date 12/25/03
Pump Tank: Gallons; PT Date
Pump Make: Model Serial No.
Nitrification Field: No Fields 1 Square Feet 1080 Linear Feet 360
No Lines 3@120' Trench Width 36" Max Trench Bottom Depth 36" Gravel Depth

☑ New System ☐ Repair System Type: I, II, III, IV, V, VI
System Description: GRAVITY 25% REDUCTION
Repair System Description: LP PANEL
Maintenance Agreement Required: ☐ Yes ☑ No


☑ House/Mod. Home No. Bedrooms 3
☐ Mobile Home No. Bathrooms 3
☐ Business No. Employees
☐ Other
☐ Slab ☑ Crawl Space ☐ Basement w/plumbing ☐ Basement wo/plumbing

Water Supply: ☑ Individual ☐ Public ☐ Community


Comments:/Conditions:

Comments:/Conditions:

INITIAL SITE SKETCH 1"=50'

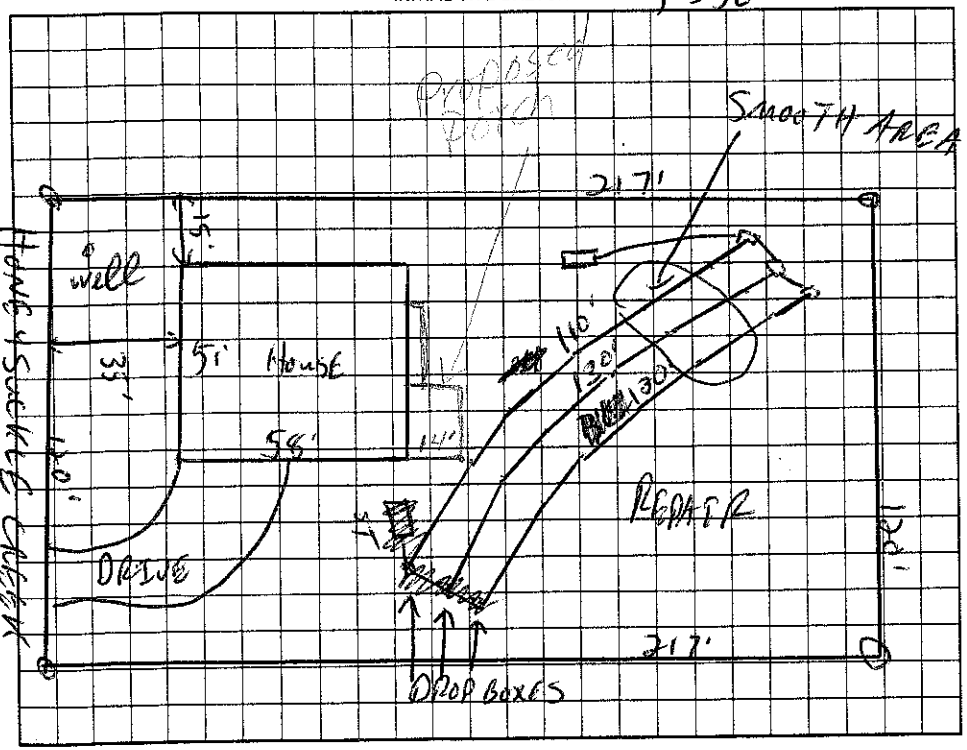

AS BUILT SKETCH

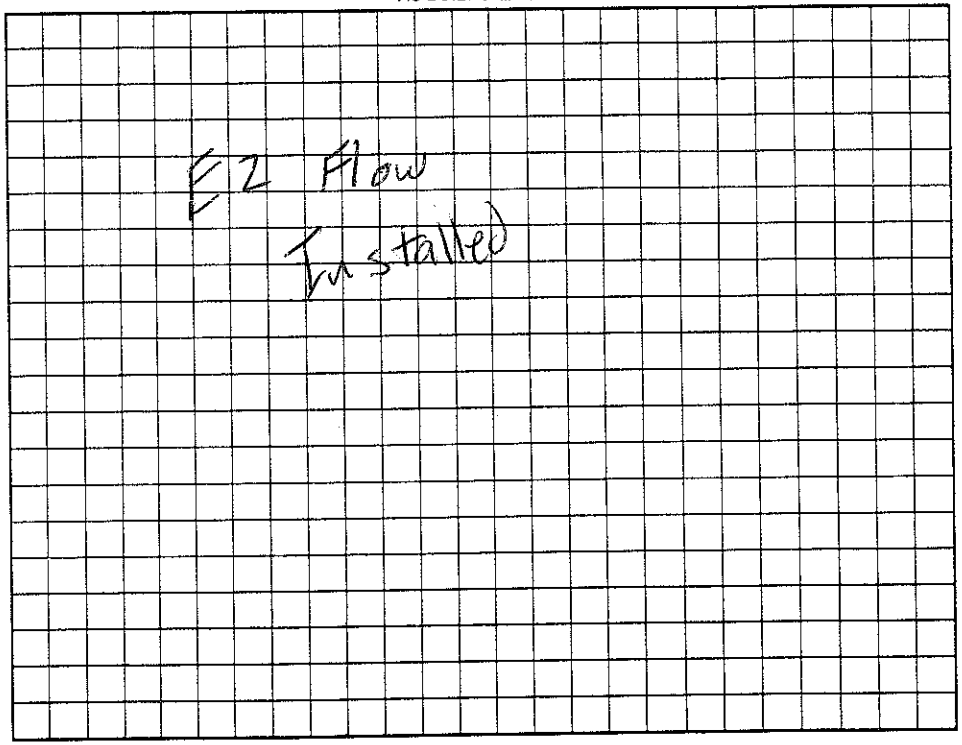

Permit can be suspended or revoked if any false information is supplied toward securing the permit/any unauthorized changes are made to the site/any unauthorized changes are made in the installation of the system. Improvement Permit with plat valid without expiration. Improvement Permit with site plan valid for sixty months. Authorization to Construct is valid for a period equal to that of Improvement Permit – not to exceed sixty months.

Signed: date 6-15-04

Improvement Permit by: RS date 6/8/04

Authorization to Construct by: RS date 6/8/04

Installed by: Larry Beam

Operation Permit by: RS date 2/1/05

Existing System Inspection by: date

HEALTH DEPT. COPY: WHITE OWNER COPY (FINAL): YELLOW OWNER COPY (INITIAL): PINK