IREDELL COUNTY HEALTH DEPARTMENT

STATESVILLE 704-878-5305 MOORESVILLE 704-664-5281

IMPROVEMENT PERMIT / AUTHORIZATION TO CONSTRUCT / OPERATION PERMIT / EXISTING SYSTEM INSPECTION

PERMIT# 116735 PIN# 4639 96 2769.22 4639-87-6160 DATE 3/31/04

OWNER OR CONTRACTOR HONEYSUCKLE CREEK LLC/PRIDE HOMES PHONE: Business 201-6465 Home

ADDRESS 227 HIDEAWAY LN MOORESVILLE NC 28117

LOCATION PERTH RD (N) - TL HONEYSUCKLE CREEK LOOP - ON RT IN CURVE

SUBDIVISION HONEYSUCKLE CREEK BLOCK / SECTION LOT 22 LOT AREA .7AC SITE CLASS. PS DESIGN FLOW 480GPD L.T.A.R. .36GPD/RT²

Septic Tank: 1000 Gallons; STB 1012 Date 3/29/05
Pump Tank: 1000 Gallons; PT 17 Date 4/22/05
Pump Make: Gouds Model WE20-511 H Serial No. 1405692726
Nitrification Field: No Fields 1 Square Feet 1200 Linear Feet 400
No Lines 4@ 50@80' Trench Width 36" Max Trench Bottom Depth 36" Gravel Depth NA

☑ New System ☐ Repair System Type: I, II, III, IV, V, VI
System Description: PUMP 25% REDUCTION
Repair System Description: LP PANEL
Maintenance Agreement Required: ☐ Yes ☑ No


☑ House/Mod. Home No. Bedrooms 4
☐ Mobile Home No. Bathrooms 4
☐ Business No. Employees
☐ Other
☐ Slab ☐ Crawl Space ☑ Basement w/plumbing ☐ Basement wo/plumbing

Water Supply: ☑ Individual ☐ Public ☐ Community


Comments:/Conditions:

Comments:/Conditions:

INITIAL SITE SKETCH 1"=50'

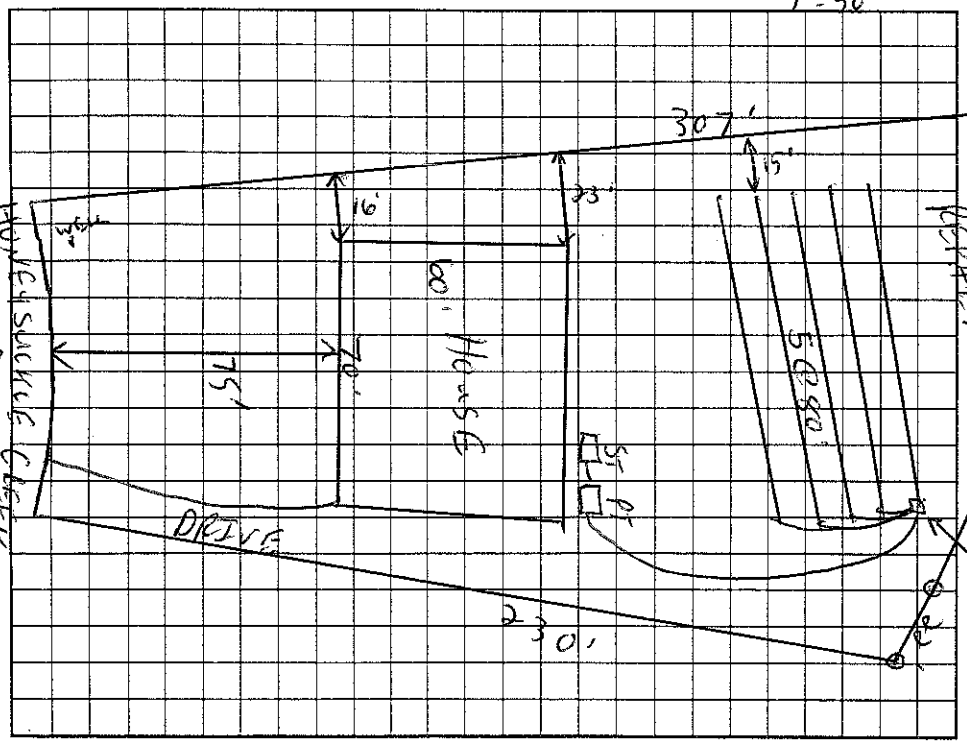

AS BUILT SKETCH

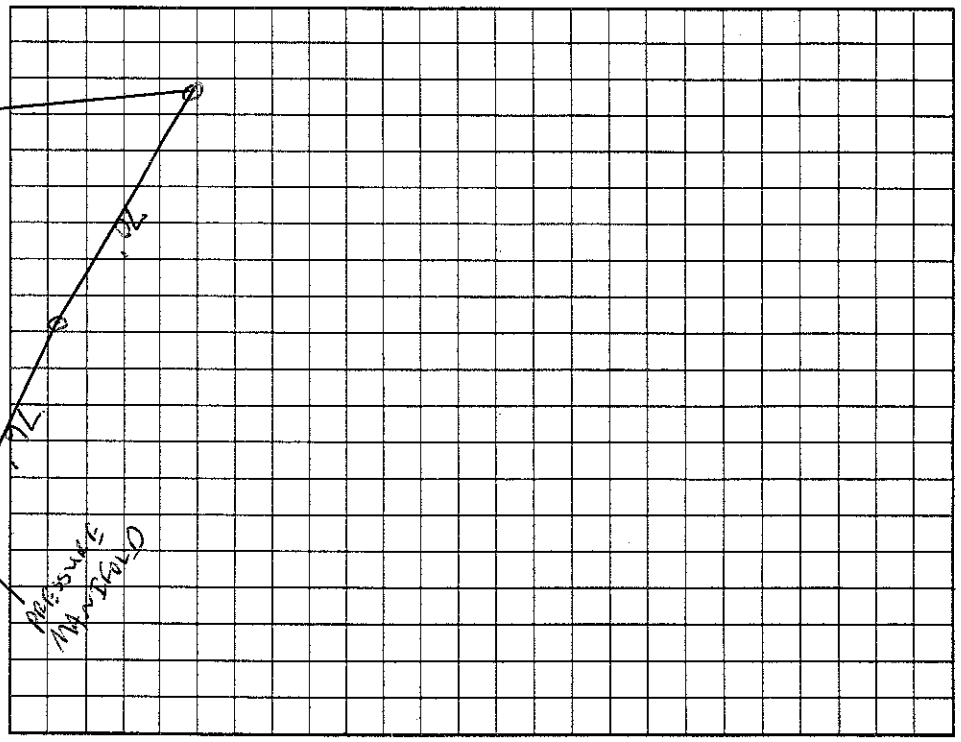

Permit can be suspended or revoked if any false information is supplied toward securing the permit/any unauthorized changes are made to the site/any unauthorized changes are made in the installation of the system. Improvement Permit with plat valid without expiration. Improvement Permit with site plan valid for sixty months. Authorization to Construct is valid for a period equal to that of Improvement Permit – not to exceed sixty months.

Signed: _____ date 4/2/04 Installed by: _____

Improvement Permit by: _____ RS date 3/31/04 Operation Permit by: _____ RS date 12/1/05

Authorization to Construct by: _____ RS. date 6/2/05 Existing System Inspection by: _____ date _____

HEALTH DEPT. COPY: WHITE OWNER COPY (FINAL): YELLOW OWNER COPY (INITIAL): PINK