IREDELL COUNTY HEALTH DEPARTMENT

STATESVILLE 704-878-5305 MOORESVILLE 704-664-5281

2:30

IMPROVEMENT PERMIT / AUTHORIZATION TO CONSTRUCT / OPERATION PERMIT / EXISTING SYSTEM INSPECTI

PERMIT# 116733 PIN# 4639.96.2769.20 4639-87-9131 DATE 3/31/04

OWNER OR CONTRACTOR HONEYSUCKLE CREEK @ LLC/Doll Enter PHONE: Business 201-6465 Home

ADDRESS 227 HIDEAWAY LANE MOORESVILLE NC 28117

LOCATION PERTH RD (N) - TL 2nd HONEYSUCKLE CK LOOP - ON RT

SUBDIVISION HONEYSUCKLE CREEK BLOCK / SECTION LOT 20 LOT AREA 1.62AC SITE CLASS PS DESIGN FLOW 480GPD L.T.A.R. .36AC/FT2

Septic Tank: 1000 Gallons; STB 825 Date 7/26/04

Pump Tank: 1000 Gallons; PT 302 Date 7/7/04

Pump Make: Zoellar Model N98 Serial No.

Nitrification Field: No Fields 1 Square Feet 1200 Linear Feet 400

No Lines 5@80' Trench Width 36" Max Trench Bottom Depth 36" Gravel Depth N/A

☑ New System ☐ Repair System Type: I, II, III, IV, V, VI

System Description: PUMP 25% REDUCTION

Repair System Description: LP PANEL

Maintenance Agreement Required: ☐ Yes ☑ No

☑ House/Mod. Home No. Bedrooms 4

☐ Mobile Home No. Bathrooms 4

☐ Business No. Employees

☐ Other


☐ Slab ☐ Crawl Space ☑ Basement w/plumbing ☐ Basement wo/plumbing

Water Supply: ☑ Individual ☐ Public ☐ Community

Comments:/Conditions: Reviewed Building plans, essentially in Compliance with IP

Comments:/Conditions:

INITIAL SITE SKETCH 1" = 50'

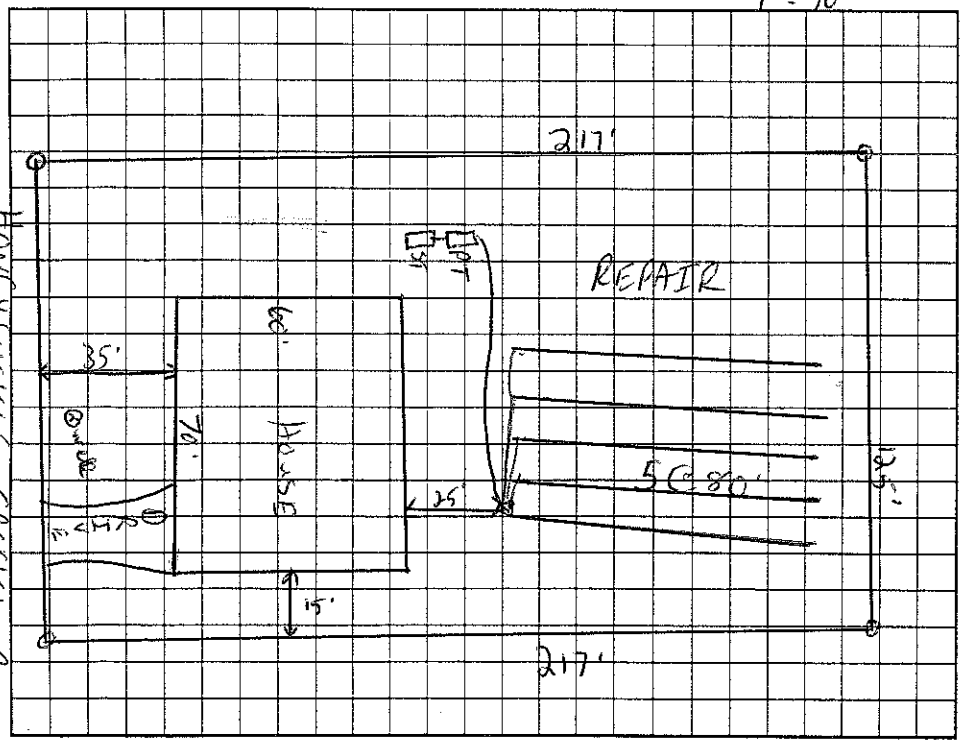

AS BUILT SKETCH

Infiltrators Installed

Permit can be suspended or revoked if any false information is supplied toward securing the permit/any unauthorized changes are made to the site/any unauthorized changes are made in the installation of the system. Improvement Permit with plat valid without expiration. Improvement Permit with site plan valid for sixty months. Authorization to Construct is valid for a period equal to that of Improvement Permit – not to exceed sixty months.

Signed: date 4-2-04 Installed by: Rowan Septic

Improvement Permit by: RS date 3/31/04 Operation Permit by: RS date 12/7/04

Authorization to Construct by: RS date 6/15/04 Existing System Inspection by: date

HEALTH DEPT. COPY: WHITE OWNER COPY (FINAL): YELLOW OWNER COPY (INITIAL): PINK