IREDELL COUNTY HEALTH DEPARTMENT

STATESVILLE 704-878-5305 MOORESVILLE 704-664-5281

IMPROVEMENT PERMIT / AUTHORIZATION TO CONSTRUCT / OPERATION PERMIT / EXISTING SYSTEM INSPECTION

PERMIT# 129517 PIN# 4730 70 5378.004 4639891966 DATE October 19, 2006

OWNER OR APPLICANT BD of N.C. Inc. PHONE: Business _____ Home _____

ADDRESS 249 Williamson Rd, Suite 101, Mooresville, N.C. 28117

LOCATION Perth Rd (N) TR Winding Forest Dr 4th lot on left 136 Winding Forest

SUBDIVISION Winding Forest BLOCK / SECTION _____ LOT 4 LOT AREA 1.157 Ac SITE CLASS. PS DESIGN FLOW 480gpd L.T.A.R. .25

Septic Tank: 1000 Gallons: STB 786 Date 3/1/07

Pump Tank: 1000 Gallons: PT 32 Date 3/4/07

Pump Make: ~~Accumaster~~ Model 137 Serial No. _____

Nitrification Field: No Fields 1 Square Feet 1440 Linear Feet 480

No Lines 4 @ 120' Trench Width 36" Max Trench Bottom Depth 36"

☒ New System ☐ Repair ☐ Expansion System Type: I- II IIIB IV V VI

System Description: pm 25% Reduction

Repair System Description: LPP PBTS

Maintenance Agreement Required: ☐ Yes ☒ No

☒ House/Mod. Home No. Bedrooms 4

☐ Mobile Home No. Persons _____

☐ Business No. Employees _____

☐ Other _____

Water Supply: ☐ Individual ☒ Public ☒ Community

Gravel Depth NA ☐ Gravity ☒ Pressure ☐ Slab ☐ Crawl Space ☒ Basement w/plumbing ☐ Basement wo/plumbing

Comments:/Conditions:

Comments:/Conditions: P-Murray

Drainline -

INITIAL SITE SKETCH

SEE Plan from Rollins Soil and Env. Services

AS BUILT SKETCH


Permit can be suspended or revoked if any false information is supplied toward securing the permit/any unauthorized changes are made to the site/any unauthorized changes are made in the installation of the system. Improvement Permit with plat valid without expiration ☐ Improvement Permit with site plan valid for sixty months ☒ Authorization to Construct is valid for a period equal to that of Improvement Permit – not to exceed sixty months.

Signed: Deana Hamilton date 10-30-06 Installed by: Gunn Contracting

Improvement Permit by: _____ date 10-19-06 Operation Permit by: Judy McNeill date 12-4-07

Authorization to Construct by: Wesley Sparks RS date 11/16/07 Existing System Inspection by: _____ date _____

HEALTH DEPT. COPY: WHITE OWNER COPY (FINAL): YELLOW OWNER COPY (INITIAL): PINK

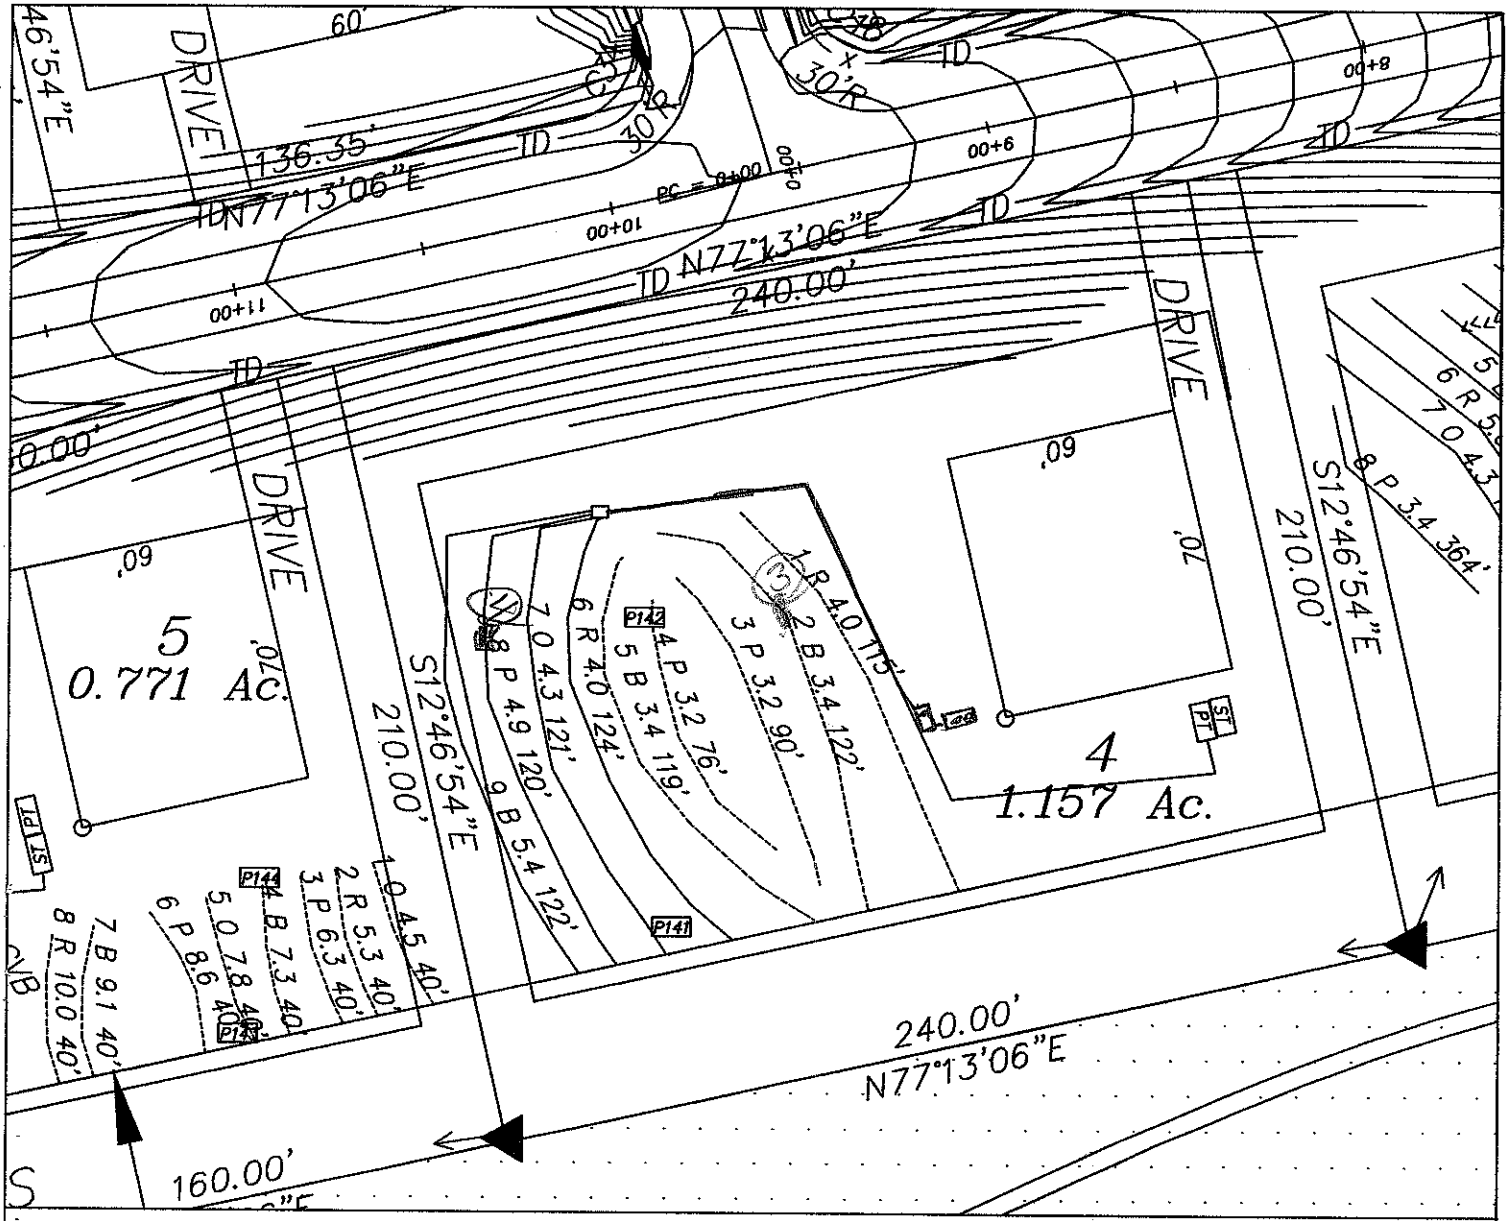

LEGEND

- House Box.
- System lines.
- Repair lines.
- House Corner Shot.
- T.B.M.

GRAPHIC SCALE

1" = 50'

50 0 50 100

FOR PRELIMINARY PLANNING PURPOSES ONLY. ALL LOTS WILL REQUIRE FINAL APPROVAL BY THE COUNTY HEALTH DEPARTMENT ON A LOT BY LOT BASIS. THIS MAP SHOULD BY USED AS A GENERAL GUIDE, SOME ADJUSTMENTS WILL BE NECESSARY IN THE FIELD DUE TO SOIL VARIABILITY AND COMPLEX TOPOGRAPHIC FEATURES.
THIS MAP ONLY REFLECTS EXISTING SOIL SUITABILITY FOR ON--SITE SEPTIC TANK SYSTEMS.

PLEASE REFER TO ATTACHED SOIL REPORT FOR ADDITIONAL SITE SPECIFIC INFORMATION

ROLLANS SOIL & ENVIRONMENTAL SERVICES
2120 GRAHAM ROAD
MOUNT ULLA, NC 28125
PHONE/FAX: (704) 278 - 0989
ASHLEY ROLLANS, NC LICENSED SOIL SCIENTIST
MOBILE: (704) 746 - 5046
EMAIL: ROLLANSFORTCJ@AOL.COM

MAP TITLE: SITE PLAN & DRAINFIELD AREAS

PROJECT NAME: 80 OF NC / WINDING FOREST

LOCATION/DATE: PERTH ROAD, IREDELL COUNTY, NORTH CAROLINA, JUNE 2008

JOB # :	01-1135
FILE:	C:\JOBS\01-1135
PROJECT MGR.:	C.B.F.
FIELD WORK:	C.B.F. & A.L.P.
DRAWN BY:	C.B.F.