IREDELL COUNTY HEALTH DEPARTMENT

STATESVILLE 704-878-5305 MOORESVILLE 704-664-5281

IMPROVEMENT PERMIT / CERTIFICATE OF COMPLETION / OPERATION PERMIT / EXISTING SYSTEM INSPECTION

PROPERTY DESCRIPTION NO. 18269 DATE 4/28/94 TAX MAP NO. 3F A 46 Watershed: ☐ Yes ☑ No

OWNER OR CONTRACTOR Christopher Davidson PHONE: Business Home 455-1284

ADDRESS 1508 Denver Dr. Concord, NC. 28025

LOCATION Neil Farm Rd. ~ 800' Gr (L)

SUBDIVISION No BLOCK / SECTION LOT LOT AREA ~1.5 AC SITE CLASS. P DESIGN FLOW 480 L.T.A.R. .3

Septic Tank: 1000 Gallons; STB 825 Date 3/1/94 ☑ New System ☐ Repair System Type: I, II, III, IV, V, VI ☑ House/Mod. Home No. Bedrooms 2 3 ☑ Individual

Pump Tank: Gallons; PT Date System Description: CONV. ☐ Mobile Home No. Bathrooms 2 2½ ☐ Community

Pump Make: Model 500 Serial No. 2616 Repair System Description: CONV. ☐ Business No. Employees ☐ Public


Nitrification Field: No Fields 1 Square Feet 400 Linear Feet Maintenance Agreement Required: ☐ Yes ☑ No ☐ Other

No Lines 3 Trench Width 3' Max Trench Bottom Depth 36" Gravel Depth ☐ Slab ☑ Crawl Space ☐ Basement w/plumbing ☐ Basement wo/plumbing

Comments: Changes made 4/28/94 other part of system

Comments: Installed as shown for I.P.

INITIAL SITE SKETCH

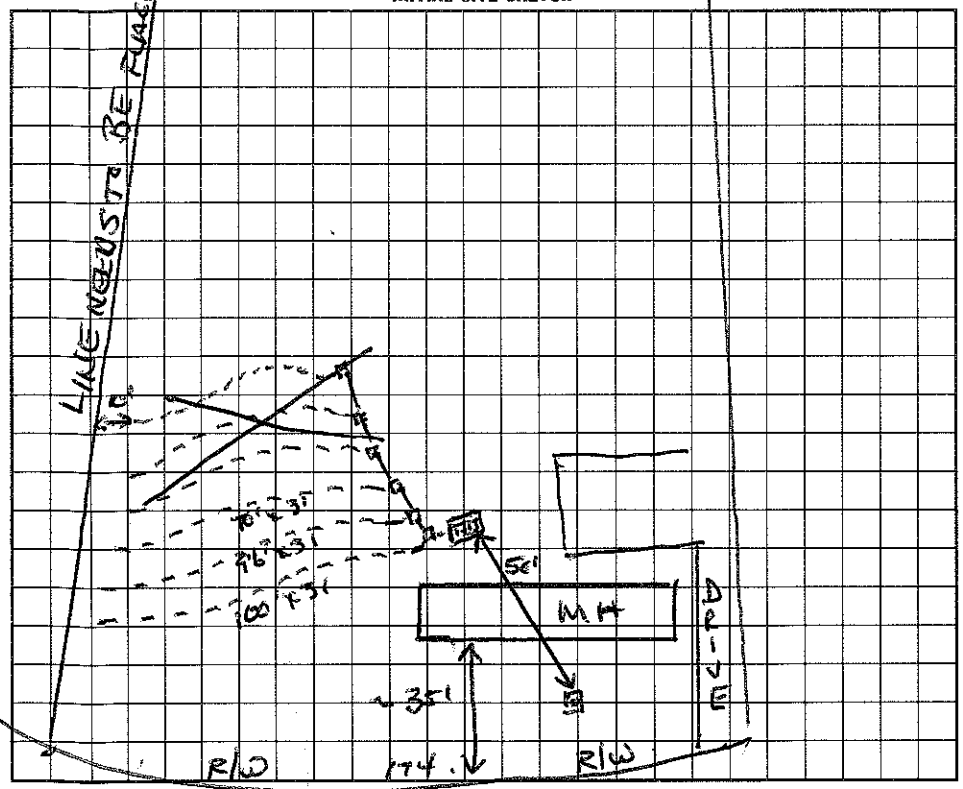

AS BUILT SKETCH

I understand that this permit can be suspended or revoked if any false information is supplied toward securing the permit/any unauthorized changes are made to the site/any unauthorized changes are made in the installation of the system. Improvement Permit is valid for 60 months from date of issuance.

Signed: Deborah Davidson NEIL FARM RD.

Improvement Permit by: Wesley Sparks RS. date 4/20/94

Existing System Inspection by: date

Installed by: Tim Ammons

Certificate of Completion by: Wesley Sparks RS. date 5/10/94

Operation Permit by: date

HEALTH DEPT. COPY: WHITE INSPECTION COPY (FINAL): GREEN OWNER COPY (FINAL): YELLOW INSPECTION COPY (INITIAL): PINK OWNER COPY (INITIAL): GOLD