IREDELL COUNTY HEALTH DEPARTMENT

Authorization to Construct 4639 89 6113

STATESVILLE 704-878-5305 MOORESVILLE 704-664-5281

IMPROVEMENT PERMIT / CERTIFICATE OF COMPLETION / OPERATION PERMIT / EXISTING SYSTEM INSPECTION

PROPERTY DESCRIPTION NO. 2345 1 DATE 4/9/96 TAX MAP NO. 3E A 108 Watershed: ☐ Yes ☒ No

OWNER OR CONTRACTOR Christopher B Davidson PHONE: Business _____ Home 528-0525

ADDRESS 147 Neill Farm Rd Troutman, NC 28166

LOCATION Perth Rd (N) to Neill Farm Rd. to 1st RH on (L) to 147

SUBDIVISION No BLOCK / SECTION _____ LOT _____ LOT AREA _____ SITE CLASS. _____ DESIGN FLOW _____ L.T.A.R. _____

Septic Tank: Existing Gallons; STB _____ Date _____

Pump Tank: _____ Gallons; PT _____ Date _____

Pump Make: _____ Model _____ Serial No. _____

Nitrification Field: No Fields 1 Square Feet 420 Linear Feet 140

No Lines 2 Trench Width 36" Max Trench Bottom Depth 36" Gravel Depth 12"

☐ New System ☐ Repair System Type: I (II) III IV V VI

System Description: Conventional - Drop Box

Repair System Description: _____

Maintenance Agreement Required: ☐ Yes ☒ No

☒ House/Mod. Home ☐ Mobile Home ☐ Business ☐ Other

No. Bedrooms 3 No. Bathrooms 3 No. Employees _____


☐ Slab ☒ Crawl Space ☐ Basement w/plumbing ☐ Basement wo/plumbing

Water Supply: ☒ Individual ☐ Community ☐ Public

Comments: Additions to original syst em - 2 lines 70' x 3' @ (1) + (2)
Crawl space must be increased to get full to Septic Tank from broken location.

Comments:

INITIAL SITE SKETCH

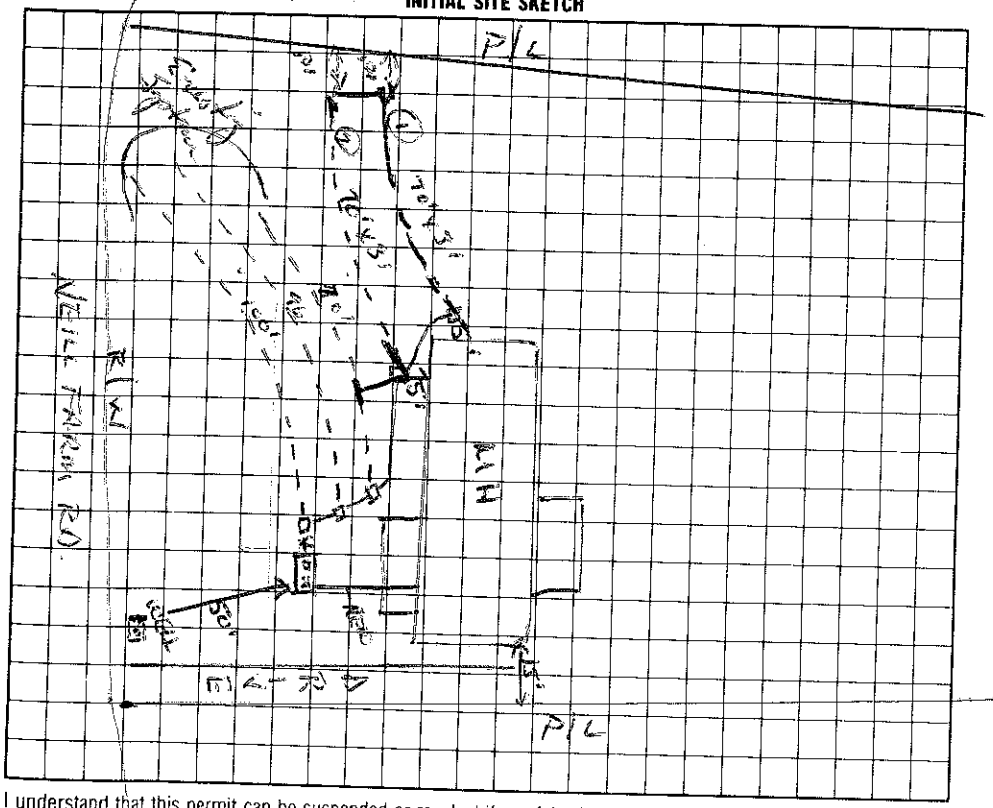

AS BUILT SKETCH

I understand that this permit can be suspended or revoked if any false information is supplied toward securing the permit/any unauthorized changes are made to the site/any unauthorized changes are made in the installation of the system.

Signed: X _____

Improvement Permit by: _____ date _____

Existing System Inspection by: Authorization to Construct Wesley Sparks RS date 4/9/96

Installed by: Dennis Belcher

Certificate of Completion by: _____ date _____

Operation Permit by: Wesley Sparks RS. date 5/14/96

HEALTH DEPT. COPY: WHITE INSPECTION COPY (FINAL): GREEN OWNER COPY (FINAL): YELLOW INSPECTION COPY (INITIAL): PINK OWNER COPY (INITIAL): GOLD