IREDELL COUNTY HEALTH DEPARTMENT

STATESVILLE 704-878-5305 MOORESVILLE 704-664-5281

IMPROVEMENT PERMIT / AUTHORIZATION TO CONSTRUCT / OPERATION PERMIT / EXISTING SYSTEM INSPECTION

PERMIT# 100209 PIN# 4659 89 6543 DATE 5/17/01

OWNER OR CONTRACTOR Charlene Davidson PHONE: Business _____ Home 528-0525

ADDRESS 147 Neill Farm Rd Troutman, NC 28166

LOCATION Perth, L Neill Farm, on Rt 1/4 Mile

SUBDIVISION _____ BLOCK / SECTION _____ LOT _____ LOT AREA 1.34 AC SITE CLASS. PS DESIGN FLOW 360 L.T.A.R. 0.5

Septic Tank: 1600 Gallons; STB 312 Date 10/17/99

Pump Tank: _____ Gallons; PT _____ Date _____

Pump Make: _____ Model _____ Serial No. _____

Nitrification Field: No Fields 1 Square Feet 1200 Linear Feet 400

No Lines 5 @ 80' Trench Width 36" Max Trench Bottom Depth 36" Gravel Depth 12"

☒ New System ☐ Repair System Type: I, (II), III, IV, V, VI

System Description: Gravity Conventional

Repair System Description: Same

Maintenance Agreement Required: ☐ Yes ☒ No

☐ House/Mod. Home No. Bedrooms 3

☒ Mobile Home No. Bathrooms 2

☐ Business No. Employees ____

☐ Other _____


☐ Slab ☒ Crawl Space ☐ Basement w/plumbing ☐ Basement wo/plumbing

Water Supply: ☒ Individual ☐ Public ☐ Community


Comments:/Conditions: Install Lines on Contour - Keep well 50' minimum from septic system

Comments:/Conditions:

INITIAL SITE SKETCH

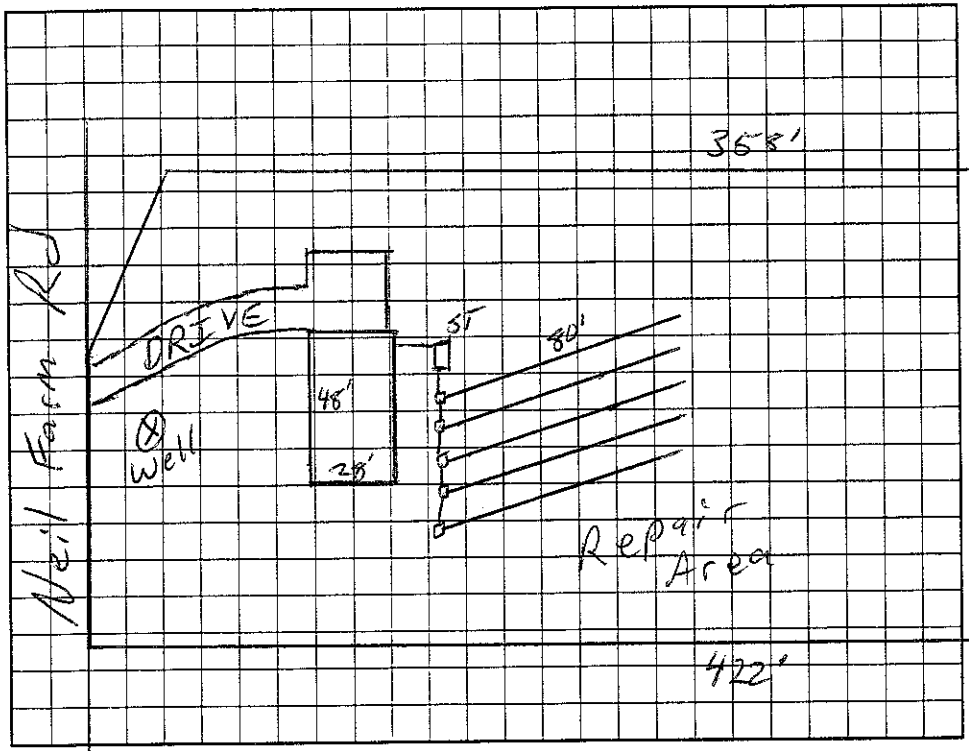

AS BUILT SKETCH

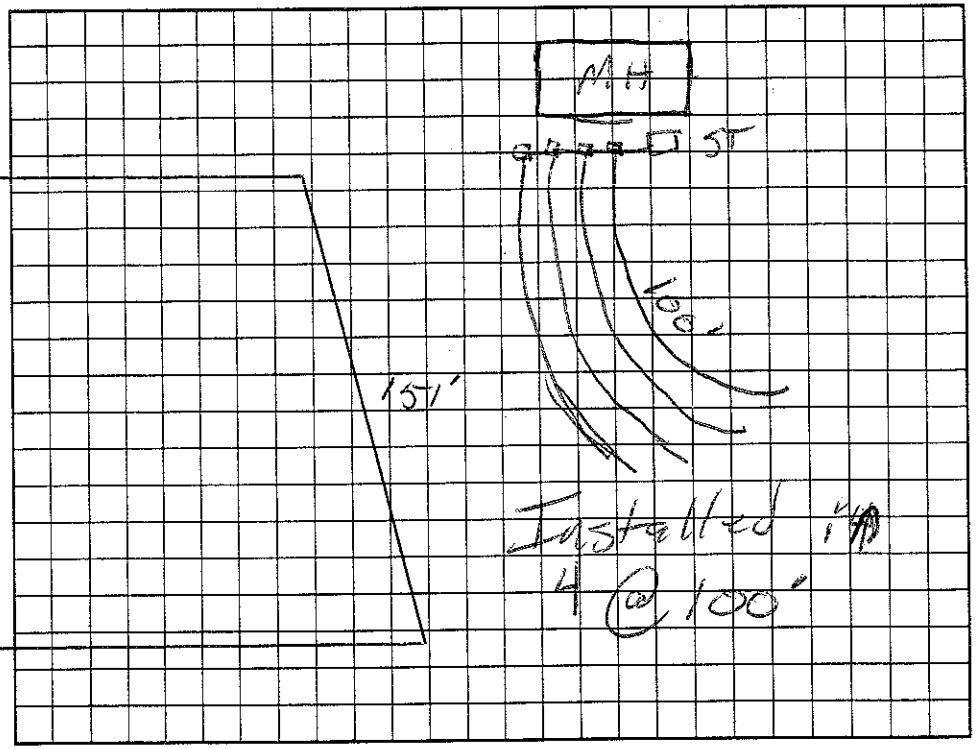

Permit can be suspended or revoked if any false information is supplied toward securing the permit/any unauthorized changes are made to the site/any unauthorized changes are made in the installation of the system. Improvement Permit with plat valid without expiration. Improvement Permit with site plan valid for sixty months. Authorization to Construct is valid for a period equal to that of Improvement Permit – not to exceed sixty months.

Signed: Dave Nichols date 5/16/01

Improvement Permit by: RS date 5/17/01

Authorization to Construct by: RS date 5/17/01

Installed by: Craig Thompson

Operation Permit by: RS date 6/12/01

Existing System Inspection by: _____ date _____

HEALTH DEPT. COPY: WHITE OWNER COPY (FINAL): YELLOW OWNER COPY (INITIAL): PINK