IREDELL COUNTY HEALTH DEPARTMENT

STATESVILLE 704-878-5305 MOORESVILLE 704-664-5281

IMPROVEMENT PERMIT / AUTHORIZATION TO CONSTRUCT / OPERATION PERMIT / EXISTING SYSTEM INSPECTION

PERMIT # 161790 PIN # 4639901195 DATE 4-5-2011

OWNER or APPLICANT Mary Conover/Ogden Construction PHONE: Business May 908 208 9487 Home: 704 799-9077

OWNER or APPLICANT ADDRESS 127 Millbros Ln Mooresville NC 28117

LOCATION / DIRECTIONS US 21 N TL Cornelius TR Creekview TL Millbros on left #127

SUBDIVISION Mills Pond BLOCK / SECTION LOT # 84 LOT AREA .69Ac DESIGN FLOW 360gpd L.T.A.R. .3

Septic Tank 1000 Gallons: STB Date

Pump Tank Gallons: P T Date

Pump Make Model Serial #

Nitrification Field No Fields 1 No Lines 5 Linear Feet 400'

Trench Width 36" Max. Trench Bottom Depth 36" Gravel Depth 12"

☐ New System ☐ Repair ☐ Expansion System Type I II III IV V VI

System Description: Exist. Gravity-Conventional

Repair System Description: Gravity 25% Reduction

Maintenance Agreement Required ☐ YES ☐ NO

☒ GRAVITY ☐ PRESSURE

☒ Residence No. Bedrooms 3

☐ Business No. Persons

☐ Other No. Employees

☐ Slab ☒ Crawl Space


☐ Basement w/plumbing ☐ Basement w/o plumbing

Water Supply: ☒ Private ☐ Public ☐ Community


Comments / Conditions: Existing Septic System appears to be Functioning ok at time of inspection

Comments / Conditions: Pool is located 15Ft from Septic System. Footers for Deck must be at least 5Ft from Septic System.

INITIAL SITE SKETCH

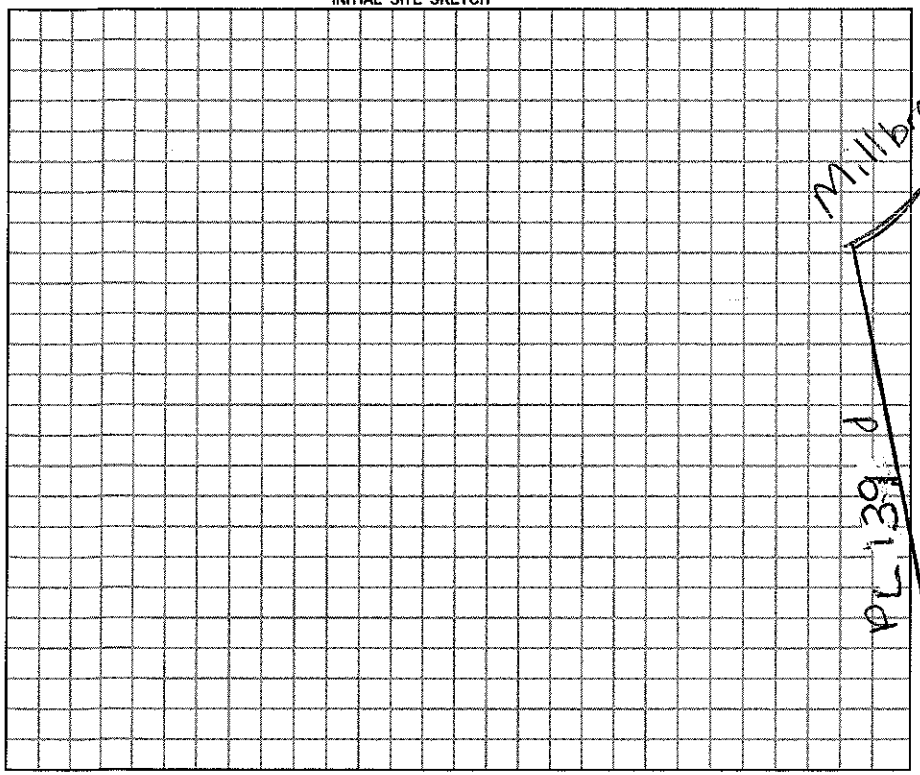

AS BUILT SKETCH

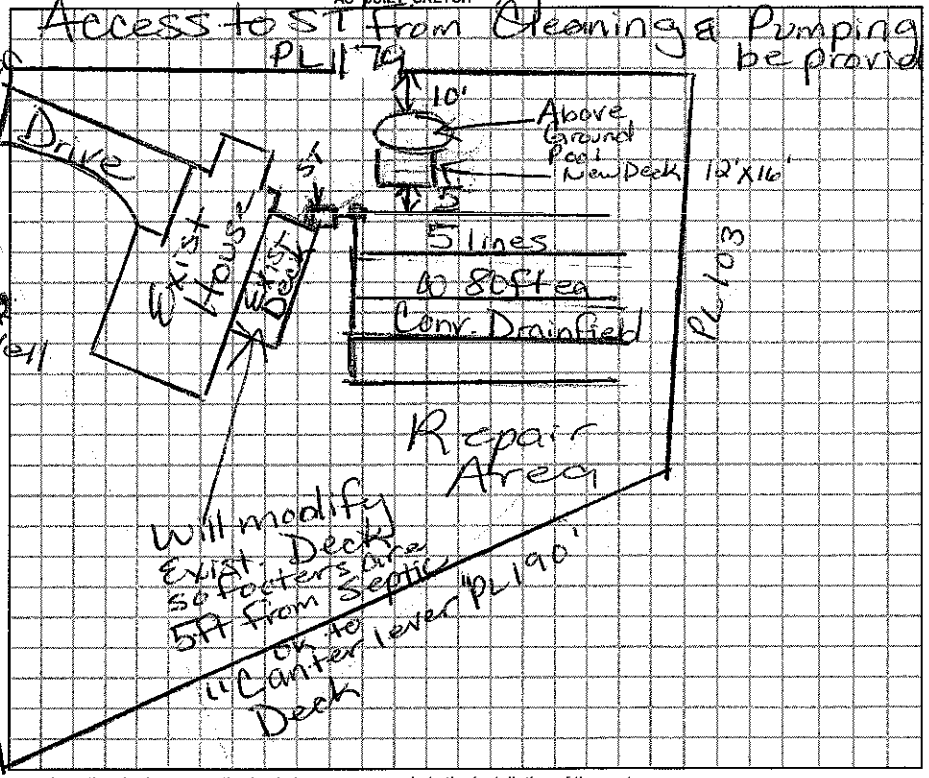

Permit can be suspended or revoked if any false information is supplied toward securing the permit / any unauthorized changes are made to the site / any unauthorized changes are made in the installation of the system.

☐ *IMPROVEMENT PERMIT w / plat valid without expiration.* ☐ *IMPROVEMENT PERMIT w / site plan valid for 60 mos.* ☐ *AUTHORIZATION TO CONSTRUCT valid for period equal to IMPROVEMENT PERMIT-not to exceed 60 mo.*

Owner / Applicant Signature: L. Shawn Ogden Date 4-7-11

Improvement Permit by: Date

Authorization to Construct by: Date

YOU SHOULD CONTACT A LOCATOR SERVICE PRIOR TO ANY EXCAVATION.

Installed by: Rowan Septic 5/2/96

Operation Permit by: Date:

Existing System Inspected by: Marina Helton RS Date: 4/5/2011

WHITE COPY Environmental Health YELLOW COPY (Final) Owner / Applicant PINK COPY (Initial) Owner / Applicant