ICHD - ENVIRONMENTAL HEALTH DIVISION

Statesville Office (704) 878-5305 | Mooresville Office (704) 660-3625 | PERMIT # AP 326827

SEPTIC: IMPROVEMENT PERMIT / AUTHORIZATION TO CONSTRUCT / OPERATION PERMIT / EXISTING SYSTEM

PIN # 4639 -- 92 -- 2809

APPLICANT/OWNER: Ganesh Kumar | APPLICANT ADDRESS: 109 Campanile Dr, Mooresville

SITE ADDRESS: 109 Campanile Dr, Mooresville 28117 | PHONE: 704-904-2863 | ALT. PHONE -

SITE DIRECTIONS: Perth - Bells Crossing - S San Agustin - Campanile | SAP CONTROLLED: ☐ YES ☒ NO


SUBDIVISION: Bells Crossing | SECTION: - | LOT # 188 | LOT AREA: 0.84 acres | DESIGN FLOW: 480 gpd | L.T.A.R.: EX

Septic Tank	EX	(gal)	STB		Date		☐ New System ☐ Repair ☐ Expansion	System Type: I II (III) IV V VI	☒ Residence	No. Bedrooms	4
Pump Tank	EX	(gal)	PT		Date		System Description:	EXISTING	☐ Business	No. Persons	8
Pump Make		Model			Serial #		Repair System Description:	EXISTING	☐ Other	No. Employees	
# Nitrification Fields	EX	# Lines	EX		Linear Ft	EX	Maintenance Agreement Required:	☐ YES ☒ NO	☒ Slab	☐ Crawl Space	
Trench Width	EX	Trench Bottom Depth(Low side)		EX	Gravel Depth	-		☐ GRAVITY ☒ PRESSURE	☐ Basement w/plumbing	☐ Basement w/o plumbing	

Water Supply: ☐ Private ☐ Public ☒ Community

Comments / Conditions: Do not drive machinary over septic when building addition. System appeared to be working at time of inspection.

INITIAL SITE SKETCH

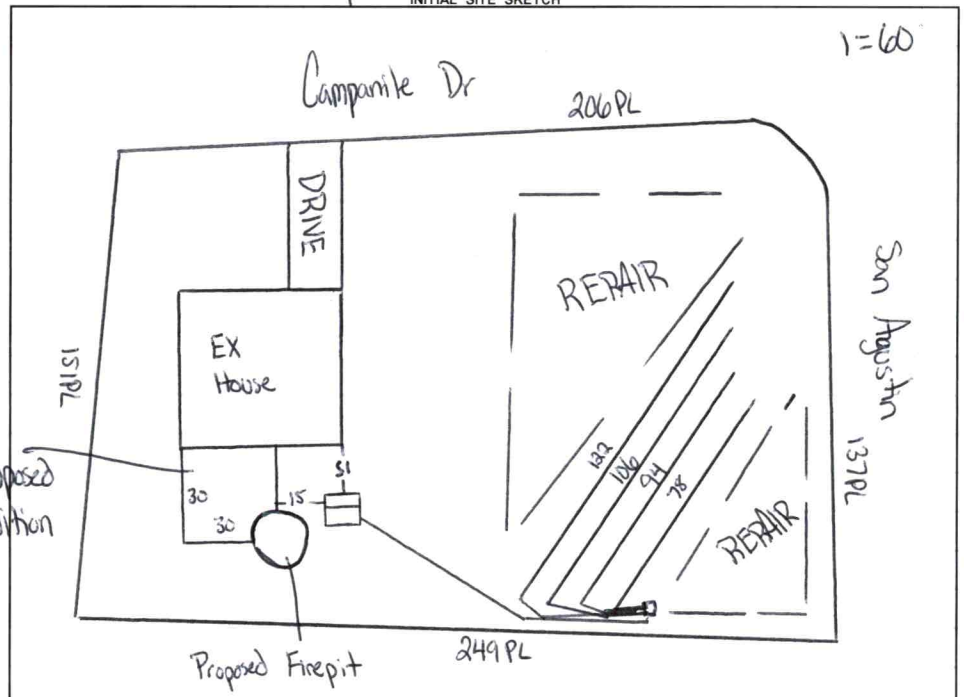

AS BUILT SKETCH

FOR SEPTIC FINAL INSPECTION CALL: 704-664-3703 between 8am-9am the day the inspection is needed. Be sure to speak with an inspector to confirm your time.

Permit can be suspended or revoked if any false information is supplied toward securing the permit / any unauthorized changes are made to the site / any unauthorized changes are made in the installation of the system. **CONTACT A LOCATOR SERVICE PRIOR TO ANY EXCAVATION**

☐ **IMPROVEMENT PERMIT *with plat*** *valid without expiration.* ☐ **IMPROVEMENT PERMIT *with site plan*** *valid for 60 mos.* ☐ **AUTHORIZATION TO CONSTRUCT** *valid for period equal to IMPROVEMENT PERMIT--not to exceed 60 mo.*

Owner / Applicant Signature: [signature] Date: 07/13/22 Installed by:

IMPROVEMENT PERMIT by: Date: OPERATION PERMIT by: Date:

AUTHORIZATION TO CONSTRUCT by: Date: Existing System Inspected by: [signature] Date: 6/17/22

FOR SEPTIC FINAL INSPECTION: CALL 704-664-3703 between 8am-9am the day the inspection is needed.

IREDELL COUNTY HEALTH DEPARTMENT

Statesville Office (704) 878-5305 Mooresville Office (704) 660-3625 PERMIT # 212216

IMPROVEMENT PERMIT / AUTHORIZATION TO CONSTRUCT / OPERATION PERMIT / EXISTING SYSTEM

PIN # 4639-92-2809

APPLICANT: BCSC APPLICANT ADDRESS: 2524 Reliance Ave. Apex, NC 27539

SITE ADDRESS: ~~227 S San. Agustin~~ 109 Campanile Dr. - Mod PHONE: 704-658-8616 ALT. PHONE:

SITE DIRECTIONS: Perth, TL Bells Crossing, TL S. San Agustin, on L

SUBDIVISION: Bells Crossing SECTION: 4 LOT # 188 LOT AREA: .84 AC DESIGN FLOW: 480 L.T.A.R.: .3

Septic Tank 1000 (gal) STB 794 Date 10-11-16

Pump Tank 1000 (gal) PT 283 Date 9-11-17

Pump Make ____ Model ____ Serial # ____

Nitrification Fields 1 # Lines 4 Linear Ft: 400'

Trench Width 36" Max Trench Bottom Depth 36" Gravel Depth —

☑ New System ☐ Repair ☐ Expansion System Type: I II III IV V VI

System Description: PM 25% Reduction

Repair System Description: Panel Block

Maintenance Agreement Required: ☐ YES ☑ NO ☐ GRAVITY ☑ PRESSURE

☑ Residence No. Bedrooms 4

☐ Business No. Persons 8

☐ Other No. Employees ____

☐ Slab ☐ Crawl Space


☑ Basement w/plumbing ☐ Basement w/o plumbing

Water Supply: ☐ Private ☐ Public ☑ Community

Comments / Conditions:

INITIAL SITE SKETCH

1"=60'

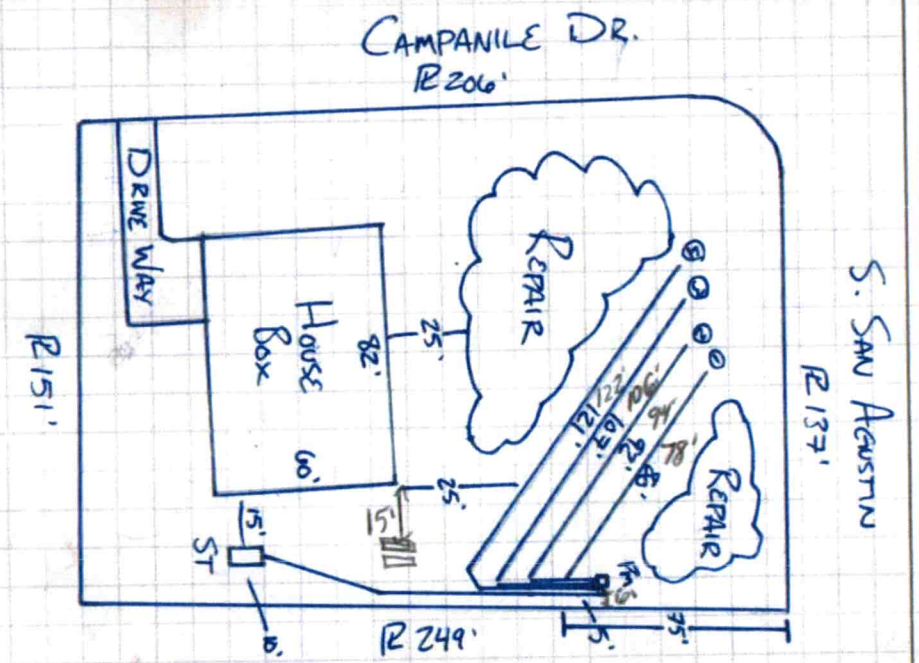

AS BUILT SKETCH

Installed as shown

TAP SIZES
1 & 2 = ½" 80
3 & 4 = ½" 40

	Date	Initials
Drain Lines Checked	10-13-17	KW
Tanks Checked	10-13-17	KW
Pressure Manifold or Valve Box Checked	10-13-17	KW
Pressure Head Set	1-11-18	KW
Electrical Checked	1-11-18	KW
Floats Set	1-11-18	KW
Alarm Checked	1-11-18	KW
Maintenance Contract Y (N)	—	—

Permit can be suspended or revoked if any false information is supplied toward securing the permit / any unauthorized changes are made to the site / any unauthorized changes are made in the installation of the system. **CONTACT A LOCATOR SERVICE PRIOR TO ANY EXCAVATION**


☐ **IMPROVEMENT PERMIT** *with plat valid without expiration.* ☑ **IMPROVEMENT PERMIT** *with site plan valid for 60 mos.* ☑ **AUTHORIZATION TO CONSTRUCT** *valid for period equal to IMPROVEMENT PERMIT--not to exceed 60 mo.*

Owner / Applicant Signature: [signature] Date: 9/25/16 Installed by: BCSC

IMPROVEMENT PERMIT by: [signature] Date: 7-25-16 OPERATION PERMIT by: [signature] Date: 1-11-18

AUTHORIZATION TO CONSTRUCT by: [signature] Date: APPROVED JUN 13 2017 Existing System Inspected by: ____ Date: ____

Health Dept. Copy - WHITE Applicant (Final Approval) - YELLOW Applicant (Conditional Approval) - PINK

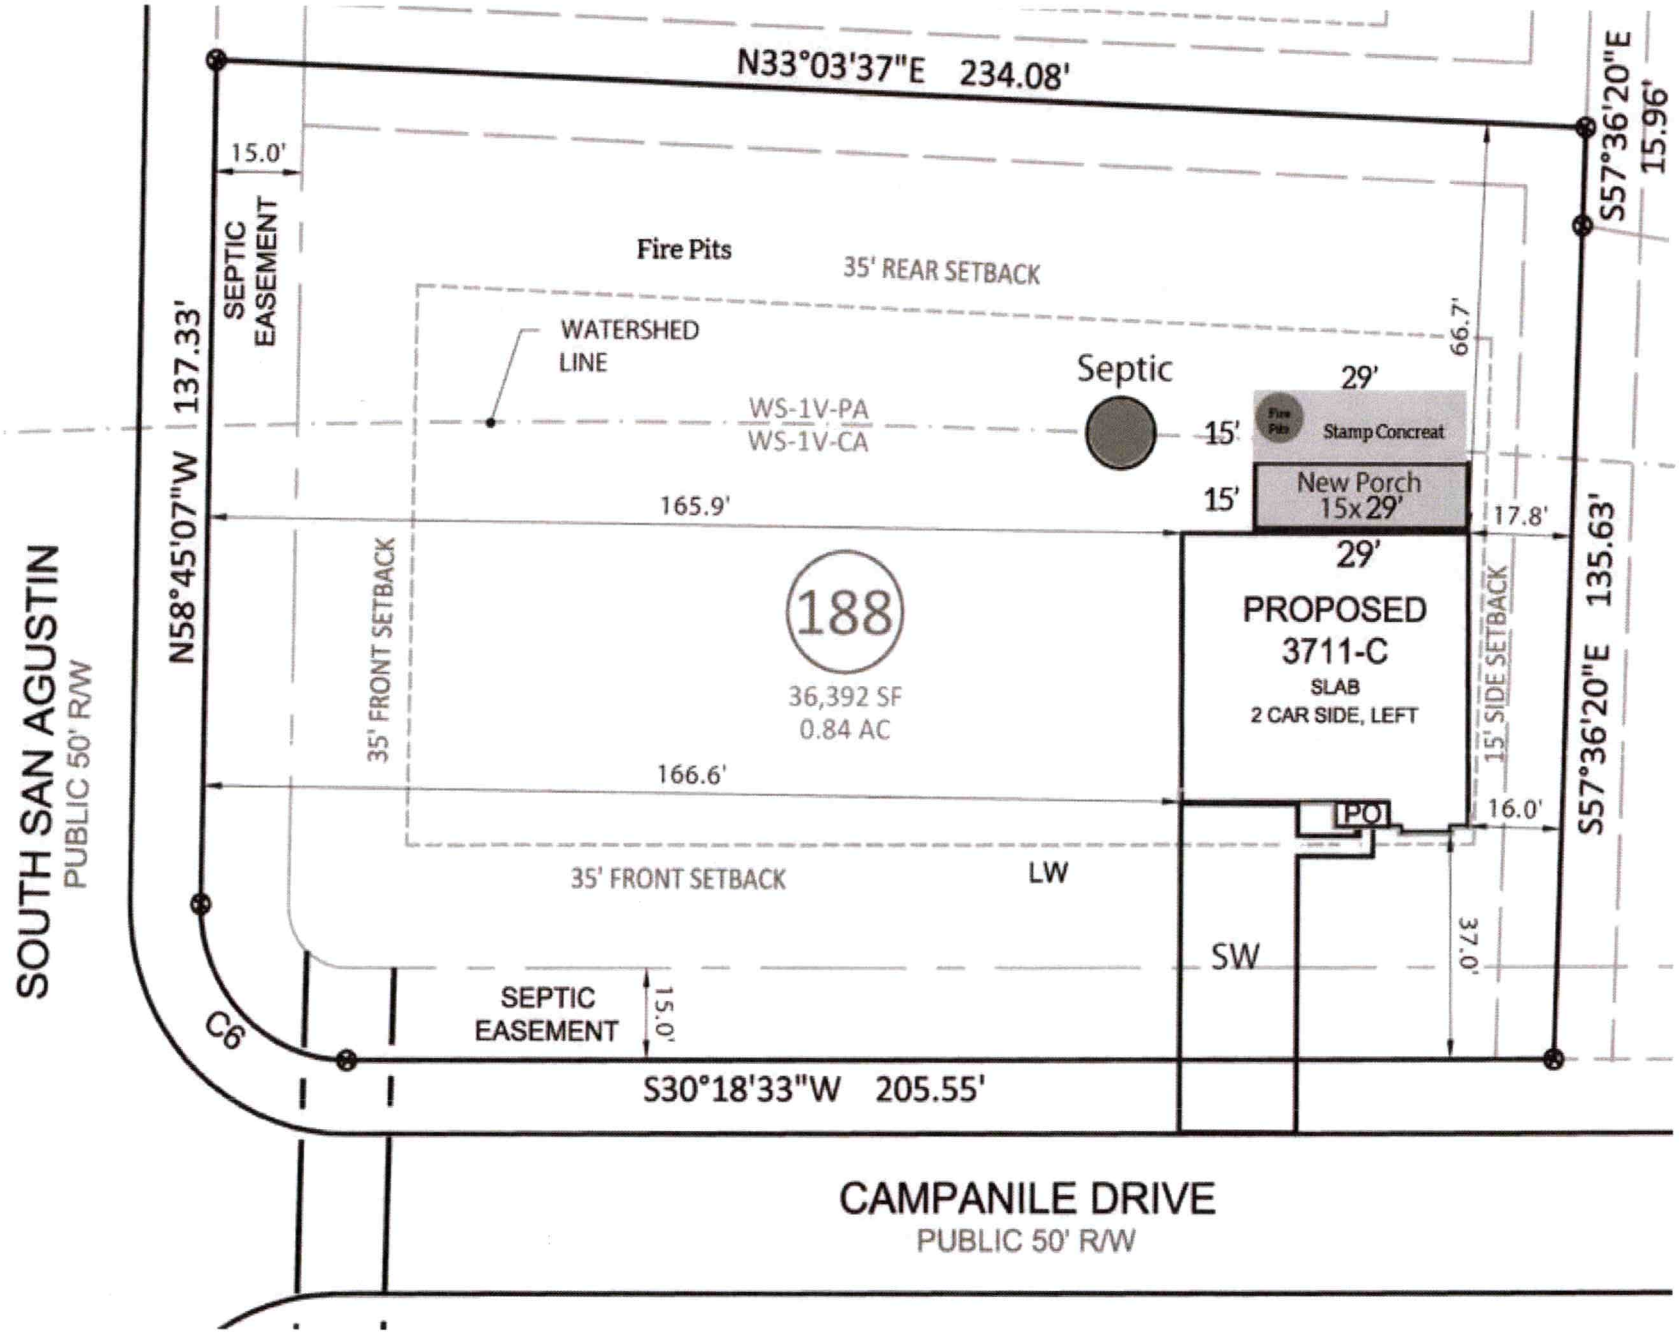
N33°03'37"E 234.08'
S57°36'20"E 15.96'
15.0'
SEPTIC EASEMENT
Fire Pits
35' REAR SETBACK
WATERSHED LINE
Septic
WS-1V-PA
WS-1V-CA
29'
15'
Stamp Concreat
66.7'
New Porch 15x29'
15'
17.8'
165.9'
29'
PROPOSED
3711-C
SLAB
2 CAR SIDE, LEFT
N58°45'07"W 137.33'
35' FRONT SETBACK
188
36,392 SF
0.84 AC
15' SIDE SETBACK
S57°36'20"E 135.63'
166.6'
PO
16.0'
35' FRONT SETBACK
LW
SW
37.0'
SOUTH SAN AGUSTIN
PUBLIC 50' R/W
SEPTIC EASEMENT
15.0'
C6
S30°18'33"W 205.55'
CAMPANILE DRIVE
PUBLIC 50' R/W

RECEIVED APR 1 2 2022

CW

APPLICATION MUST BE FILLED OUT COMPLETELY & BE LEGIBLE OR IT WILL NOT BE PROCESSED

Iredell County Health Department – Environmental Health Division

PAGE 1: *APPLICATION FORM* AP- 326827 $250.00

Application For: ( ) New Well Permit ( ) Well Repair Permit ( ) Well Abandonment
( ) Septic Improvement Permit (✓) Authorization to Construct ( ) Existing System Inspection ( ) Septic System Repair

THE ABOVE PERMIT DOCUMENTS WILL BECOME INVALID IF INFORMATION PROVIDED ON THIS APPLICATION IS FALSIFIED OR CHANGED, OR IF THE SITE IS ALTERED. THE IMPROVEMENT PERMIT IS VALID FOR EITHER 60 MONTHS OR WITHOUT EXPIRATION DEPENDING UPON DOCUMENTATION SUBMITTED. APPLICATION WITH SITE PLAN 60 MONTHS, APPLICATION WITH COMPLETE, SCALED PLAT WITHOUT EXPIRATION. SEE 15A NCAC 18A .1937(f) FOR DETAILS.

Page 2: *Site Plan Worksheet* form MUST accompany this application

The following optional attachments may also be submitted: (✓) Survey Plat, scaled no more than 1 inch = 60 feet
Place an (X) beside whichever is submitted if applicable ( ) Custom Site Plan, scaled no more than 1 inch = 60 feet

Applicant Information: (PRINT CLEARLY)

Applicant Name: Ganesh Kumar **Address:** 109 Campanile Drive, Mooresville NC **Zip:** 28117

Applicant Email: kokiganesh@yahoo.com **Phone:** (704) 904-2863 **Alt. Phone:**

Owner Name: Ganesh Kumar **Address:** 109 Campanile Drive, Mooresville NC **Zip:** 28117

Owner Email: kokiganesh@yahoo.com **Phone:** (704) 904-2863 **Alt. Phone:**

Property Information:

Street Address: 109 Campanile Drive, Mooresville NC 28117

Subdivision Name: Bills Crossing **Section/Phase:** **Lot Number:** 188

Driving Directions: From Iredell County EMS Perth Base: Head south on Perth Rd towards Bells Crossing Drive

Turn right onto Bells Crossing Drive, Turn left onto S San Agustin Dr, Turn left onto Campanile Dr, Destination will be on the left

Site Development Information: *(check or complete ALL that apply*

CHECK FOUNDATION TYPE

( ) New Single Family Residence — Maximum Number of Bedrooms: 4 — ( ) Crawl Space Foundation
( ) New Multi-Family Residence — Maximum Number of Occupants: — (✓) Concrete Slab Foundation
(✓) Accessory Building — ( ) Swimming Pool — ( ) Basement with Plumbing
( ) Bedroom(s) Addition — ( ) Other Addition/Structure: Sun Porch — ( ) Basement without Plumbing
( ) Repair to failing septic system ___ Tank ___ Drain lines Describe Problem:

Non-Residential Site Development: Type of Business:
Square Footage of Building: Max. Number of Employees: Max. Number of Seats/Beds/Other:

Water Supply: ( ) Replacement Well – Reason:
( ) Multi-connection Well Number of Houses: Number of Persons:

( ) New Well ( ) Existing Well ( ) Community Well ( ) City Water ( ) Other Public Water

Desired Septic System Type: *(you may rank in order of preference)* Year existing system installed:
( ) No Preference ( ) Alternative ( ) Conventional ( ) Innovative ( ) Modified Conventional ( ) Other:

Please answer the following to the best of your ability:

( ) Yes (✓) No Does the site contain any jurisdictional wetlands?
( ) Yes (✓) No Is any non-domestic sewage (i.e. industrial) to be generated?
( ) Yes (✓) No Is the site subject to approval by any other public agency?

I have read this application and certify that the information provided herein is true, complete, and correct. Authorized county and state officials are granted right of entry to conduct necessary inspections to determine compliance with applicable laws and rules. I understand that I am solely responsible for the proper identification and labeling of all property lines and corners and making the site accessible so that a complete site evaluation can be performed.

Signature: _____ 03-14-22


Property owner or owner's legal representative signature (SIGNATURE REQUIRED) DATE

IREDELL COUNTY HEALTH DEPARTMENT

ENVIRONMENTAL HEALTH DIVISION

PAGE 2: *SITE PLAN WORKSHEET*

SEE THE "SAMPLE SITE PLAN" BELOW. *INCOMPLETE SITE PLANS WILL BE RETURNED TO YOU FOR COMPLETION AND MAY RESULT IN A DELAY IN THE ISSUANCE OF YOUR SEPTIC SYSTEM PERMIT!!!*

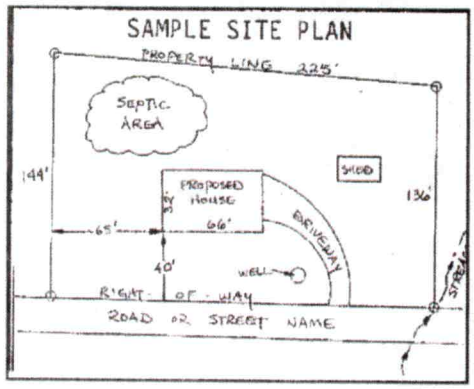

Place an (X) beside each item as you complete the site plan:


- (X) Property Line measurements are clearly identified
- (X) All proposed structures are indicated
- (X) Front and side setbacks from property line
- ( ) Preferred driveway location and well location
- ( ) Area you prefer your septic system to be placed
- ( ) North arrow, or other sufficient indicator of direction

Circle N/A on the following if appropriate:

Location of septic systems and wells within 100' of your property	N/A
Location of easements and rights of ways on your property	N/A
Location of any designated wetlands on the property	N/A

USE THIS SPACE TO DRAW YOUR SITE PLAN

Show: proposed house or business footprint, wells, water lines, patios, pools and decks, and any other item that will occupy space on the site

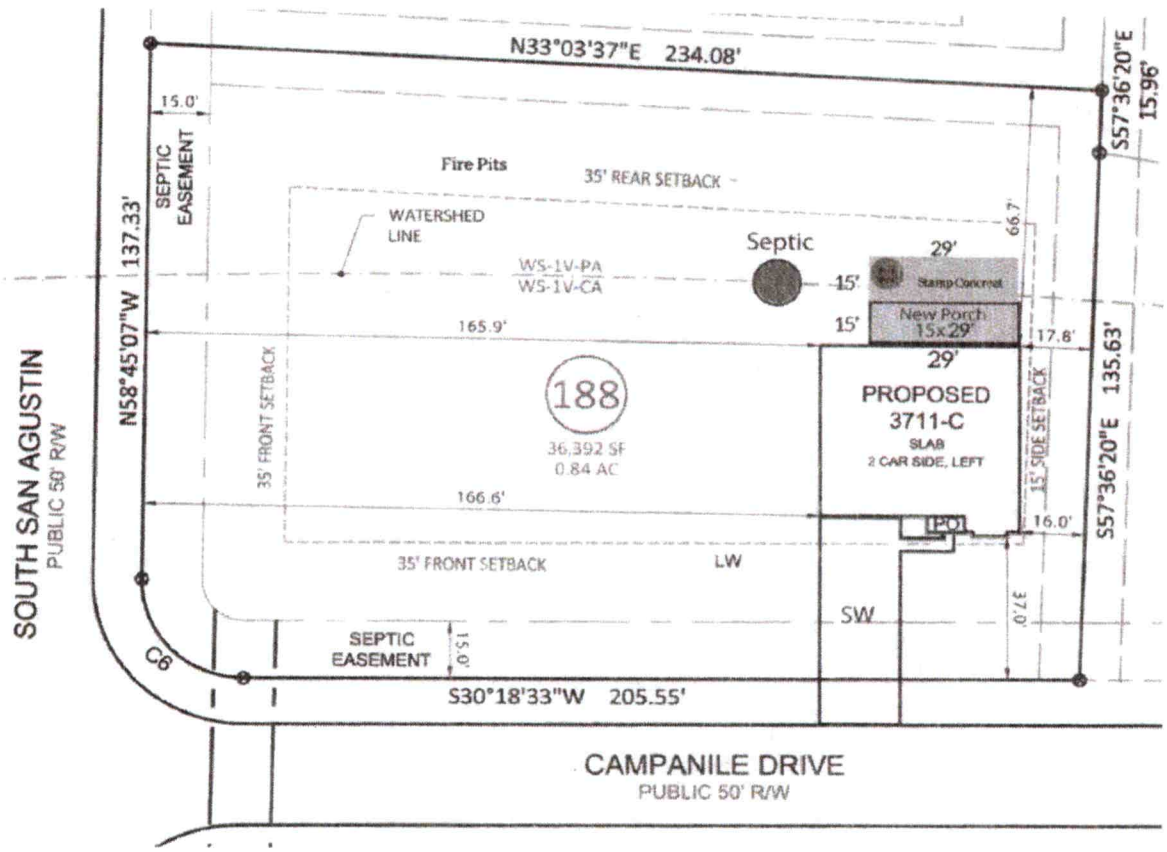

Signature: _____ 03-14-22

Property owner or owner's legal representative signature (SIGNATURE REQUIRED) — DATE

IREDELL COUNTY DEPARTMENT OF ENVIRONMENTAL HEALTH

DOCUMENTATION TO AUTHORIZE AN OWNER'S LEGAL REPRESENTATIVE

(Check and sign only ONE of the options below)

☑ **1. * APPLICANT AND OWNER ARE THE SAME. *** (*Sign here*) _____

Applications for permits require the "signature of the owner or owner's legal representative" (15A NCAC 18A .1937). If the owner does not sign the application himself or herself, they can submit any one of the following documents to designate their legal representative: *Power of Attorney; Real Estate Contract; Estate executor; Bankruptcy trustee; Court ordered guardianship*
In the absence of the above documentation, the property owner may provide the local health department with documentation that designates a legal representative. A property owner may:
Complete this form to document his or her legal representative, or provide his or her own form that contains the information in this form. If there are multiple property owners, then all property owners must sign the form that designates a legal representative.
By signing a form that designates a legal representative for purposes of 15A NCAC 18A .1937, the property owner authorizes that representative to act on their behalf in matters pertaining to the application and permitting process, including signing or receiving any application, document or permit. The owner retains full responsibility to meet all permit conditions specified by the local health department.

☐ **2.** I, _____, am the legal owner(s) of the property located at _____, identified as PIN (Parcel Identification Number)_____, located in Iredell County, North Carolina.

I do hereby authorize (**print legal representative/company name**) _____, _____, to act as an agent on my behalf in applying for/signing/obtaining any of the documents described below.

- Application for Improvement Permit (IP) / Authorization to Construct (AC)
- Improvement Permit (IP) / Authorization to Construct (AC)
- Application for soil-site evaluation (new/repair)
- Application/permit for private drinking water well/well abandonment
- Application for Compliance Inspection

I agree to abide by all decisions and/or conditions between the legal representative acting on my behalf and the Iredell County Department of Public Health, Environmental Health Division.

_____ 02-25-22

Signature of Owner(s) Date

Mooresville - Environmental Health
Fax: 704-662-3239
610 E. Center Avenue, Mooresville, NC 28115

Statesville - Environmental Health
ronda.hart@co.iredell.nc.us
Fax: 704-871-3483
349 N. Center Street, Statesville, NC 28677

ENVIRONMENTAL HEALTH REQUIREMENTS for SEPTIC and WELL PERMITS

The following items must be completed *PRIOR* to the *SUBMITTAL* of any Environmental Health Application. Incomplete applications will be returned to the applicant and cannot be processed or placed on the work list.

*** Initial all lines below to indicate you have submitted each form and completed every site requirement ****

____ **Complete all Environmental Health forms**:

- DL Application
- DL Site Plan including the dimensions of proposed structure, addition, pool etc.
- DL Documentation to Authorize Owner Agent (even if the property owner is the applicant – complete section 1 or 2)
- DL Copy of Zoning Permit when applicable
- DL Sign this sheet after you have completed all items

DL **Lot must be cleared of heavy undergrowth**. In order to evaluate the lot, the footprint of the proposed structure must be visible. Adequate area for the septic drain field and repair area must be sufficiently cleared of heavy undergrowth, with 50 feet of visibility in all directions. Inspectors must be able to evaluate the property, shoot laser level elevations, layout the drain field, do soils work, etc. **If the lot is not cleared sufficiently, then a $100 site revisit fee will be charged and the evaluation will be put on HOLD until the requirement is met.**

DL **Clearly mark all property corners by locating existing iron or concrete markers.** Flag all property lines every 25 feet if adjacent corners are not visible when standing on any given corner. Property lines must be flagged by a licensed NC surveyor & easily identified **prior to application submittal** (exception may apply for septic repair evaluations only). 'Mow lines' and/or fence lines do NOT constitute marked lines. **If the property lines are not properly marked when the lot is ready to be evaluated, then the application will be put on HOLD and a $100 site re-visit fee charged**.

DL **Stake or flag the footprint of the proposed structure, addition, pool etc. to match the site plan submitted**. The proposed structure, etc. must be staked out on the property as per the site plan.

____ **If an Authorization to Construct (AC) is desired,** submit a recorded copy of the plat for newly created or subdivided lot(s) and a LEGIBLE copy of the basic floor plan no larger than 8 ½" x 14" for each floor of the structure including decks, porches, etc. **The overall dimensions must be clearly noted & the rooms labeled.**

Any site not meeting the above requirements when staff arrives for the evaluation will result in a $100 site revisit fee being charged and the request being placed on HOLD. This will delay the processing of the application. *Once work by Environmental Health staff begins, the up-front fees paid toward securing any health department permit are nonrefundable. Refunds for work not started, due to a customer changing their mind or plans, are subject to an administrative fee of $50 to defray a portion of the costs of processing the refund.*

Backhoe pits are required for all applications that require a soils evaluation.
DO NOT DIG PITS UNTIL THE EH SPECIALIST HAS AUTHORIZED AND SCHEDULED YOUR EVALUATION TIME.

- **All utilities shall be marked before pits are dug. Call NC 811 for this service.**
- The applicant/agent is responsible for securing these services
- Backhoe pits are to be dug at the locations and depths determined by the Environmental Health Specialist or a NC Licensed Soil Scientist. A minimum of four pits must be dug.
- The EH specialist will contact you when your application is ready to be processed for pit scheduling.
- Your backhoe operator must be on site during the EH Specialist's evaluation to prevent your operator from having to return to the property for additional work.

By signing below, I am acknowledging the above specifications have been met and the site is READY to be evaluated AND I understand the backhoe pit requirement and will secure those services (if applicable).

Signature _____ **Date** 02-25-22

Questions? Contact the Environmental Health Offices below:

Statesville Office
349 North Center Street (2nd Floor Building Standards)
Statesville, NC 28677-4063
Phone: (704)878-5305 ext. 3456

Mooresville Office
610 East Center Avenue (2nd Floor Govt. Center South)
Mooresville, NC 28115-2548
Phone: (704)660-3625