
APPROVED JAN 15 2016

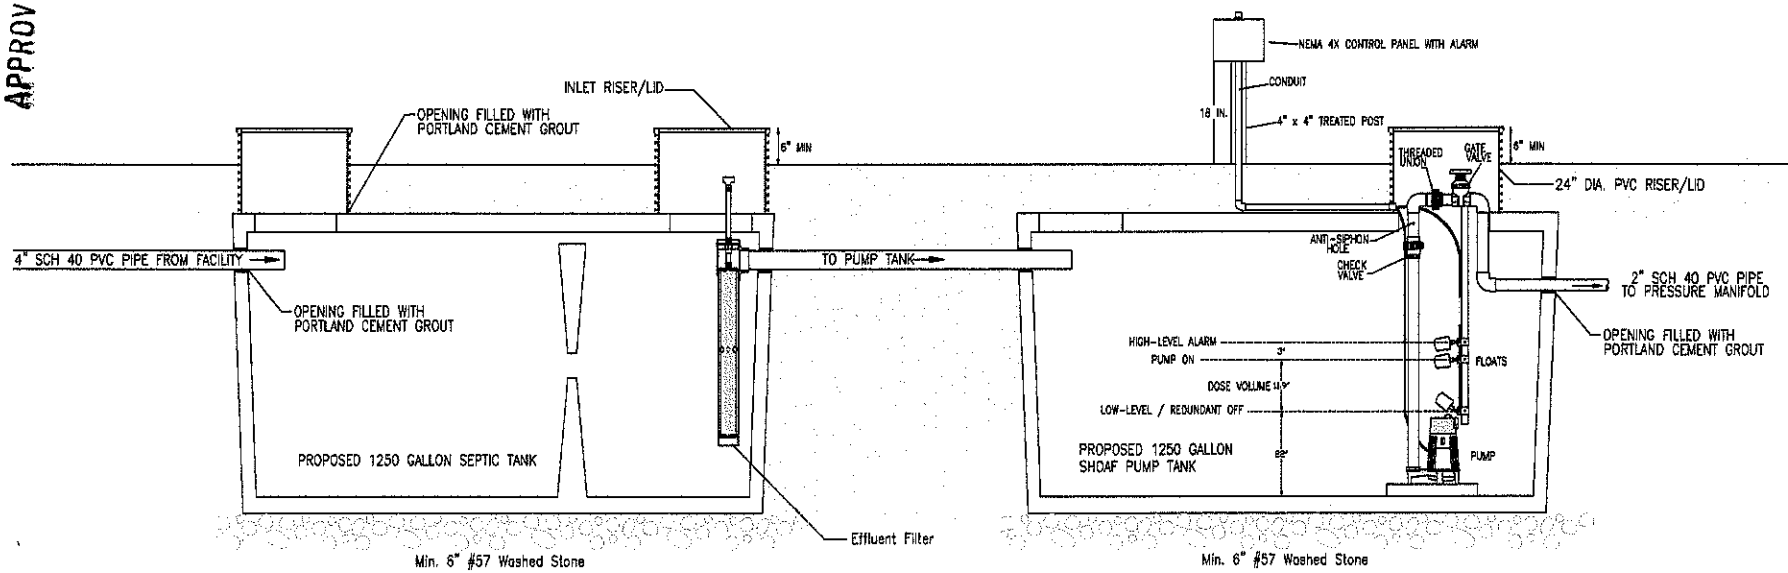

NOTES:

1. **CONTROL PANEL SHALL HAVE A VISUAL AND AUDIO ALARM**
2. **FINAL GRADE SHOULD SHED WATER AWAY FROM TANKS**
3. **TANKS SHALL BE CONSTRUCTED IN ACCORDANCE WITH STATE RULE 15A NCAC 18A .1953**


Bateman Civil Survey Company
Engineers • Surveyors • Planners
200 N. Main Street, Holly Springs, NC 27540 Ph: 919.577.1080 Fax: 919.577.1081
www.batemancivilsurvey.com info@batemancivilsurvey.com
NCBELS Firm No. C-2378

TANK DETAILS - LOT 152
FOR
Meritage Homes


SELLS CROSSING SUBDIVISION LOT 191
MOORESVILLE, NC
IREDELL COUNTY

DATE: 12/08/15 DRAWN BY: TWB CHECKED BY: TWB
SCALE: AS SHOWN

PRESSURE MANIFOLD DETAILS
TOP VIEW

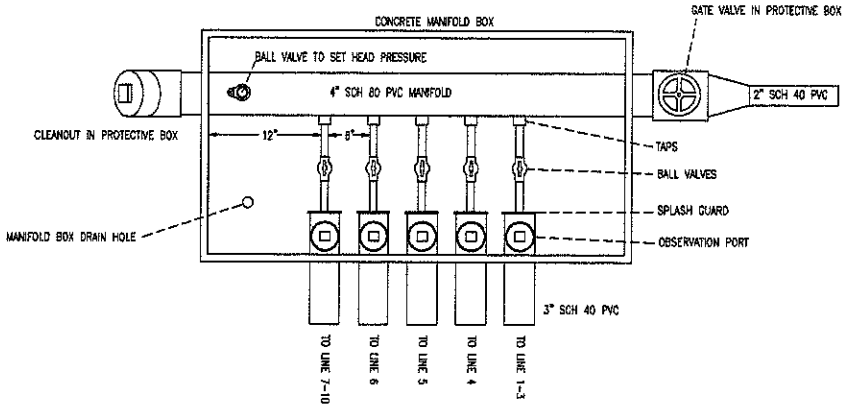

PRESSURE MANIFOLD DETAILS
END VIEW

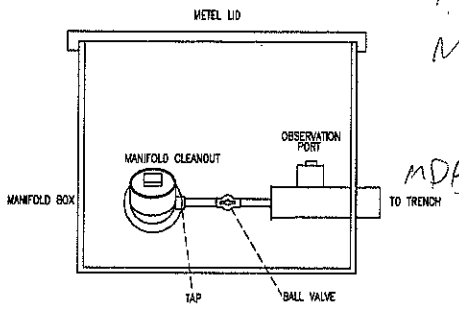


1-15-16

MDB 2-3

MDB 2-8

TAP SCHEDULE	
LINE #	TAP
~~1-3~~	3/4" SCH 40
4	1/2" SCH 40
5	1/2" SCH 40
6	1/2" SCH 40
~~7-10~~	3/4" SCH 40

The
Quick4® Standard
Chamber

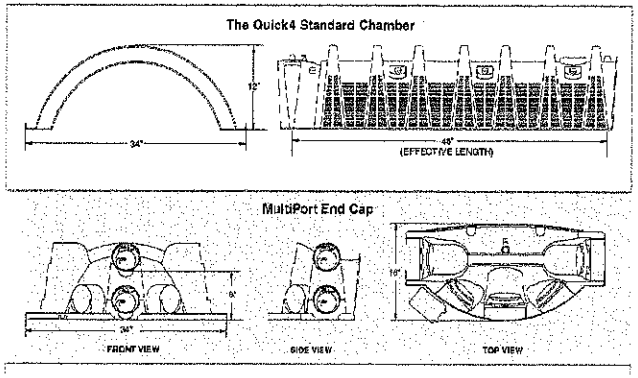

INFILTRATOR CHAMBER DETAILS

MANIFOLD DETAILS - LOT 191
FOR
Meritage Homes

Bateman Civil Survey Company
Engineers • Surveyors • Planners
200 N. Main Street, Holly Springs, NC 27540 Ph: 919.577.1080 Fax: 919.577.1081
www.batemancivilsurvey.com Info@batemancivilsurvey.com
NCBELS Firm No. C-2378

BELLS CROSSING SUBDIVISION LOT 191
MOORESVILLE, NC
IREDELL COUNTY
DATE: 12/08/15 DRAWN BY: TMB CHECKED BY: TVB
SCALE: AS SHOWN