PIN# 4639-94-4107

IREDELL COUNTY HEALTH DEPARTMENT

STATESVILLE 704-878-5305 MOORESVILLE 704-664-5281

IMPROVEMENT PERMIT / AUTHORIZATION TO CONSTRUCT / OPERATION PERMIT / EXISTING SYSTEM INSPECTION

PERMIT# ~~15250~~ 206723 PIN# 4639953410415.0830 - Bells Crossing LLC DATE 10-7-05

OWNER OR APPLICANT ~~Ryan West Developers/Rollans Env~~ PHONE: Business 704 361-1054 Home

ADDRESS 127 B Promenade Dr. Mooresville, NC 28117

LOCATION Perth Rd North TL Bells Crossing TL Belfry lot on left

SUBDIVISION Bells Crossing BLOCK / SECTION I LOT 99 LOT AREA .88 Acre SITE CLASS. PS DESIGN FLOW 450gpd L.T.A.R. .4 Initial/.275 Repair

Septic Tank: 1000 Gallons; STB INFILTRATOR Date

Pump Tank: Gallons; PT Date

Pump Make: Model Serial No.

Nitrification Field: No Fields 1 Square Feet 915 Linear Feet 305

No Lines 4 Trench Width 36" per Max Trench Bottom Depth 36" Gravel Depth N/A ☒ Gravity ☐ Pressure

☒ New System ☐ Repair ☐ Expansion System Type: I (II) III IV V VI

System Description: Gravity - 25% Reduction

Repair System Description: Pump LP - Panel Blk

Maintenance Agreement Required: ☐ Yes ☒ No

☒ House/Mod. Home ☐ Mobile Home ☐ Business ☐ Other

No. Bedrooms 4 No. Persons No. Employees

Water Supply: ☐ Individual ☒ Public ☒ Community

☐ Slab ☒ Crawl Space ☐ Basement w/plumbing ☐ Basement wo/plumbing

Comments:/Conditions: Initial Site Plan evaluation performed by Rollans Soil & Environmental

Comments:/Conditions:

INITIAL SITE SKETCH

See Attached Approved plan by Rollans Environmental

AS BUILT SKETCH

1 DRAINFIELD OK 6/4/15

- INSTALLED AS DRAWN
- QUICK 4 CHAMBERS

CHECKED TANK 6-11-15 BA

Permit can be suspended or revoked if any false information is supplied toward securing the permit/any unauthorized changes are made to the site/any unauthorized changes are made in the installation of the system. Improvement Permit with plat valid without expiration ☐ Improvement Permit with site plan valid for sixty months ☐ Authorization to Construct is valid for a period equal to that of Improvement Permit – not to exceed sixty months.

Signed: date 11/10/08

Improvement Permit by: Mark Tolson RS date 10/7/05

Authorization to Construct by: ~~APPROVED~~ date


Installed by: Carolina Life - Brian Hurst

Operation Permit by: ~~APPROVED~~ JUN 0 8 2015

Existing System Inspection by: APPROVED JUN 11 2015

HEALTH DEPT. COPY: WHITE OWNER COPY (FINAL): YELLOW OWNER COPY (INITIAL): PINK

APPROVED MAR 26 2015

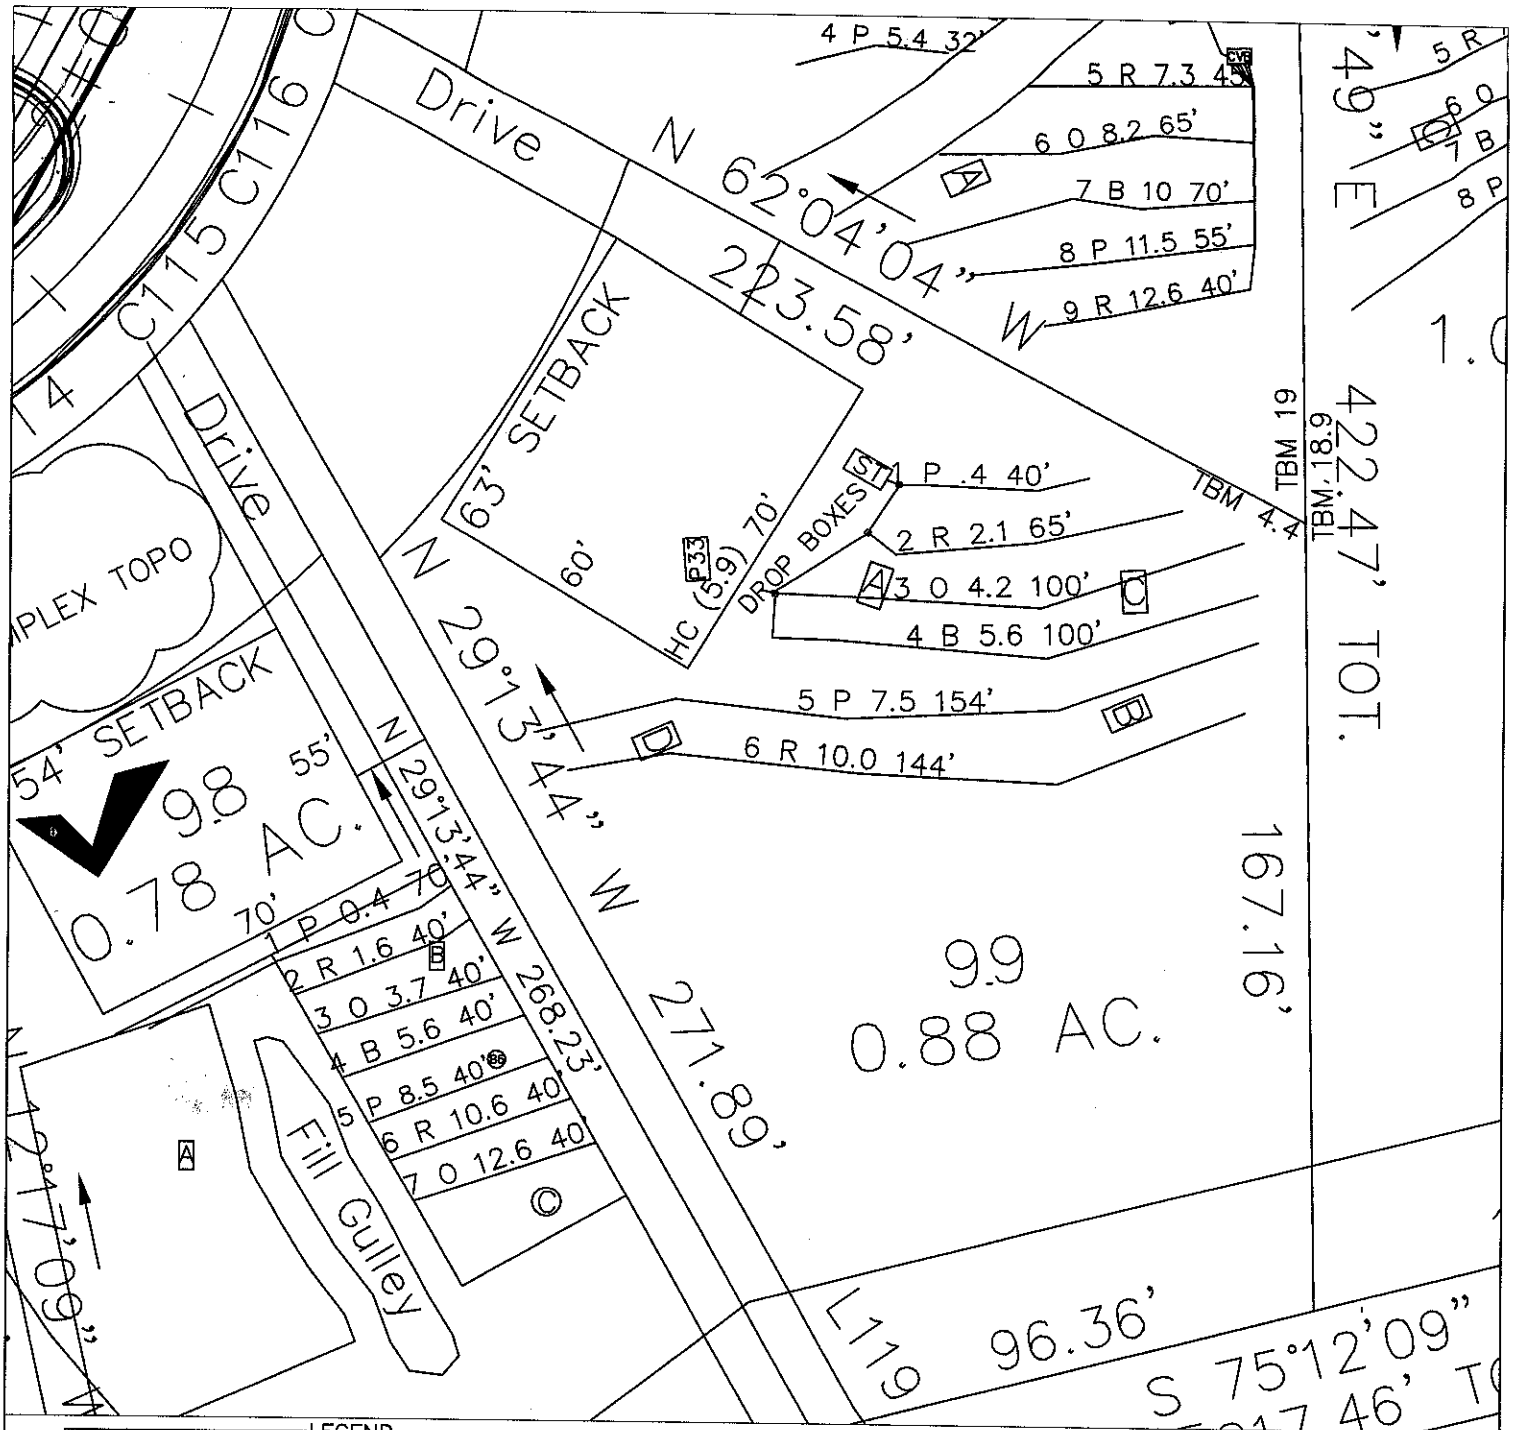

LEGEND

House Box.

System lines.

Repair lines.

GRAPHIC SCALE
1" = 40'

40 0 40 80

FOR PRELIMINARY PLANNING PURPOSES ONLY. ALL LOTS WILL REQUIRE FINAL APPROVAL BY THE COUNTY HEALTH DEPARTMENT ON A LOT BY LOT BASIS. THIS MAP SHOULD BY USED AS A GENERAL GUIDE, SOME ADJUSTMENTS WILL BE NECESSARY IN THE FIELD DUE TO SOIL VARIABILITY AND COMPLEX TOPOGRAPHIC FEATURES. THIS MAP ONLY REFLECTS EXISTING SOIL SUITABILITY FOR ON-SITE SEPTIC TANK SYSTEMS.

PLEASE REFER TO ATTACHED SOIL REPORT FOR ADDITIONAL SITE SPECIFIC INFORMATION

ROLLANS SOIL & ENVIRONMENTAL SERVICES
470 NORTH BROAD STREET SUITE D
MOORESVILLE, NC 28115
PHONE: (704) 658-1723
FAX: (704) 658-1724

BRADY FREEMAN, JR.
MOBILE: (704) 746 - 6497
EMAIL: BFREE2006@YAHOO.COM

ASHLEY ROLLANS, NC LICENSED SOIL SCIENTIST
MOBILE: (704) 796 - 8046
EMAIL: ROLLANS6@WINDSTREAM.NET

MAP TITLE: SITE PLAN & DRAINFIELD AREAS

PROJECT NAME: BELLS CROSSONG, LLC / BELLS CROSSING

LOCATION/DATE: PERTH RD, IREDELL COUNTY, NORTH CAROLINA, SEP 2006

JOB # : 01-1429
FILE: C:\JOBS\01-1429
PROJECT MGR.: C.B.F.
FIELD WORK: C.B.F., A.L.P. & M.D.B.
DRAWN BY: C.B.F. & M.D.B.