IREDELL COUNTY HEALTH DEPARTMENT

STATESVILLE 704-878-5305 ✓ MOORESVILLE 704-664-5281

#3191 Septic Cert #9136

IMPROVEMENT PERMIT / AUTHORIZATION TO CONSTRUCT / OPERATION PERMIT / EXISTING SYSTEM INSPECTION

PERMIT # 150933 PIN # 4639-94-7697 DATE 9-26-12

OWNER or APPLICANT MERITAGE HOMES PHONE: Business 704-351-5405 Home:

OWNER or APPLICANT ADDRESS 7760 BALLENTYNE COMMONS PKWY SUITE 105

LOCATION / DIRECTIONS PERTH, TURN INTO BELLS CROSSING, ON R

SUBDIVISION BELLS CROSSING BLOCK / SECTION LOT # 54 LOT AREA .709AC DESIGN FLOW 600 L.T.A.R. .275

Septic Tank 1500 Gallons: STB 974 Date 5

Pump Tank 1500 Gallons: P T Date

Pump Make Model Serial #

Nitrification Field No Fields 1 No Lines 7 Linear Feet 587'

Trench Width 36" Max. Trench Bottom Depth 36" Gravel Depth —

☒ New System ☐ Repair ☐ Expansion System Type I II (III) IV V VI

System Description: 25% REDUCTION

Repair System Description: LP- PANEL BLOCK

Maintenance Agreement Required ☐ YES ☒ NO

☒ GRAVITY ☐ PRESSURE

☒ Residence No. Bedrooms 5 ☐ Business No. Persons ☐ Other No. Employees


☒ Slab ☐ Crawl Space ☐ Basement w/plumbing ☐ Basement w/o plumbing

Water Supply: ☐ Private ☐ Public ☒ Community

Comments / Conditions ① IF CHAMBERS ARE USED, END CAPS CAN REPLACE DROP BOXES


Comments / Conditions 11/9/12 Checked upper 4 lines

INITIAL SITE SKETCH

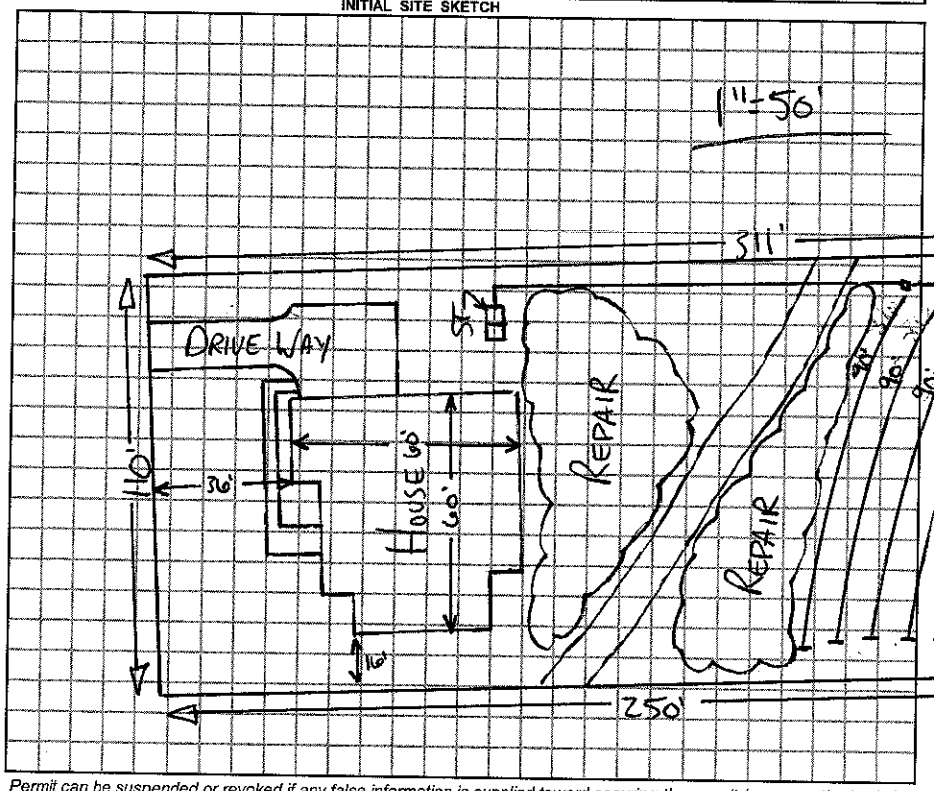

AS-BUILT SKETCH

Installer Chuck H. Drawn 11/15/12 Checked last 3 lines (Sept Check) 4 Strand Dist (no Drop boxes)

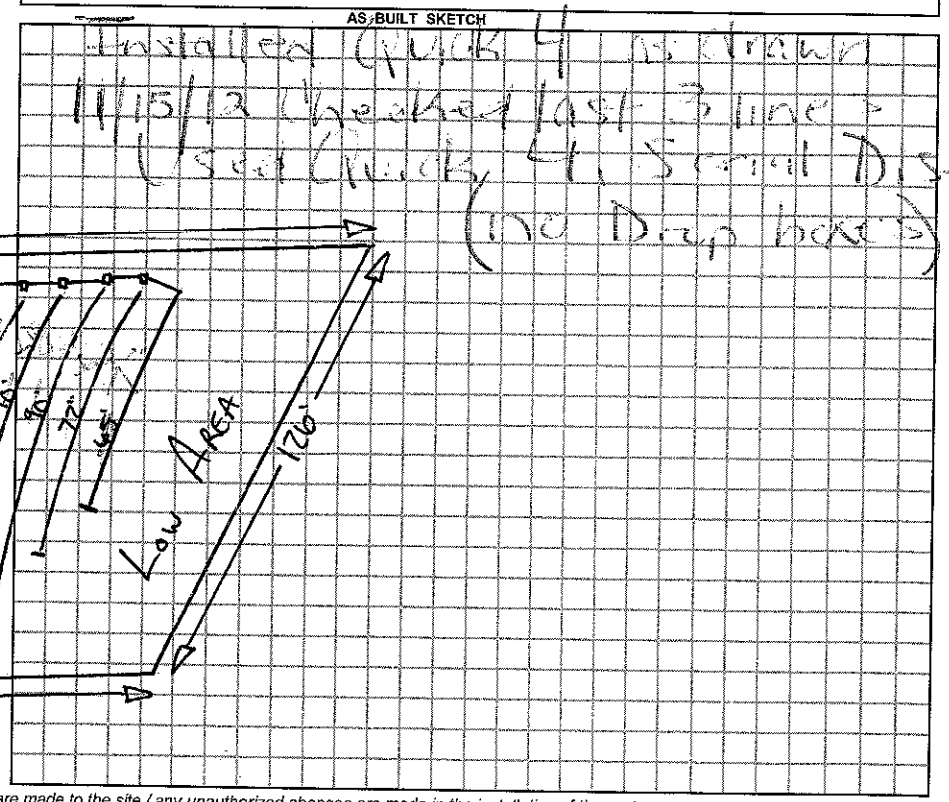

Permit can be suspended or revoked if any false information is supplied toward securing the permit / any unauthorized changes are made to the site / any unauthorized changes are made in the installation of the system.

☒ *IMPROVEMENT PERMIT w / plat valid without expiration.* ☐ *IMPROVEMENT PERMIT w / site plan valid for 60 mos.* ☐ *AUTHORIZATION TO CONSTRUCT valid for period equal to IMPROVEMENT PERMIT-not to exceed 60 mo.*

Owner / Applicant Signature: [signature] Date 9-28-12

Improvement Permit by: RA-CC REHS Date 9-28-12

Authorization to Construct by: RA-CC REHS Date 9-29-12

YOU SHOULD CONTACT A LOCATOR SERVICE PRIOR TO ANY EXCAVATION.

Installed by: Carolina Pipe Cleaning Inc

Operation Permit by: [signature] Date: 11/15/12

Existing System Inspected by: Date:

WHITE COPY Environmental Health YELLOW COPY (Final) Owner / Applicant PINK COPY (Initial) Owner / Applica