IREDELL COUNTY HEALTH DEPARTMENT

Statesville Office (704) 878-5305 Mooresville Office (704) 660-3625 PERMIT # MP 211305

IMPROVEMENT PERMIT / AUTHORIZATION TO CONSTRUCT / OPERATION PERMIT / EXISTING SYSTEM

PIN # 4639-95-5962.000 5110

APPLICANT: Russell Woolf APPLICANT ADDRESS: 1045 Doolie Rd. Mooresville NC

SITE ADDRESS: 119 Leaning Tower Dr. Mooresville NC PHONE: 704-236-7338 ALT. PHONE: 262-408-3179

SITE DIRECTIONS: Exit 36 To Bells Crossing, R San Agustin, L Leaning Tower

SUBDIVISION: Bells Crossing SECTION: 2 LOT # 46 LOT AREA: .770 Acre DESIGN FLOW: Ex. 480 GPD L.T.A.R.: Ex. .3

Septic Tank Existing (gal) STB Date
Pump Tank (gal) PT Date
Pump Make Model Serial #
Nitrification Fields Ex # Lines Existing Linear Ft: Existing
Trench Width Existing Max. Trench Bottom Depth Existing Gravel Depth N/A

☐ New System ☐ Repair ☐ Expansion System Type: I II ☒ III IV V VI
System Description: Existing 25% Red. - Gravity
Repair System Description: ~~System~~ LS - Panel
Maintenance Agreement Required: ☐ YES ☒ NO
☒ GRAVITY ☐ PRESSURE

☒ Residence No. Bedrooms Ex. 4
☐ Business No. Persons Ex. 8
☐ Other No. Employees
☒ Slab ☒ Crawl Space
☐ Basement w/plumbing ☐ Basement w/o plumbing


Water Supply: ☐ Private ☐ Public ☒ Community

Comments / Conditions: System Appeared To Be Functioning At Time of Inspection.
Maintain 5' Separation From Septic with Deck Addition.

INITIAL SITE SKETCH

1" = 60'

AS BUILT SKETCH

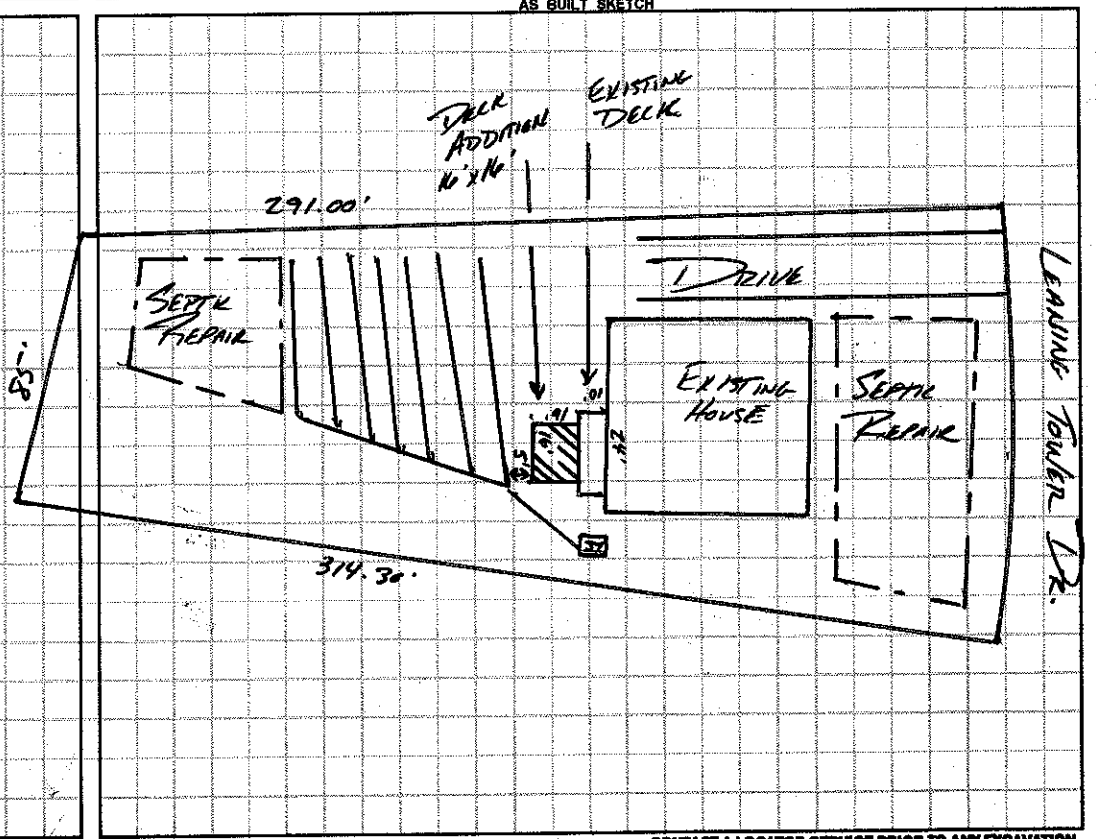

Permit can be suspended or revoked if any false information is supplied toward securing the permit / any unauthorized changes are made to the site / any unauthorized changes are made in the installation of the system. **CONTACT A LOCATOR SERVICE PRIOR TO ANY EXCAVATION**

☐ **IMPROVEMENT PERMIT *with plat*** *valid without expiration.* ☐ **IMPROVEMENT PERMIT *with site plan*** *valid for 60 mos.* ☐ **AUTHORIZATION TO CONSTRUCT** *valid for period equal to IMPROVEMENT PERMIT--not to exceed 60 mo.*

Owner / Applicant Signature: Russell Woolf Date: 11-2-15 Installed by:

IMPROVEMENT PERMIT by: Date: OPERATION PERMIT by: Date:

AUTHORIZATION TO CONSTRUCT by: Date: Existing System Inspected by: APPROVED Date: JUN 24 2015

Health Dept. Copy - WHITE Applicant (Final Approval) - YELLOW Applicant (Conditional Approval) - PINK