IREDELL COUNTY HEALTH DEPARTMENT

Statesville Office (704) 878-5305 Mooresville Office (704) 660-3625 PERMIT # 2100 181577

IMPROVEMENT PERMIT / AUTHORIZATION TO CONSTRUCT / OPERATION PERMIT / EXISTING SYSTEM

PIN # 4639-95-5540.000

APPLICANT: MERITAGE HOMES APPLICANT ADDRESS: 7761 BALLANTYNE COMM. PKWY CHARLOTTE

SITE ADDRESS: 120 LEANING TOWER DR. PHONE: 704-309-6577 ALT. PHONE:

SITE DIRECTIONS: BELLS, TR N. SAN AGUSTINE, TL LEANING TOWER

SUBDIVISION: BELL'S CROSSING SECTION: 2 LOT # 30 LOT AREA: 1.12AC DESIGN FLOW: 600 L.T.A.R.: .3

Septic Tank	1500	(gal)	STB		Date						
Pump Tank		(gal)	PT		Date						
Pump Make			Model		Serial #						
# Nitrification Fields	1	# Lines	5C100'	Linear Ft:	500'						
Trench Width	36"	Max. Trench Bottom Depth	36"	Gravel Depth							

☒ New System ☐ Repair ☐ Expansion System Type: I II (III) IV V VI

System Description: 25% REDUCTION

Repair System Description: PANEL

Maintenance Agreement Required: ☐ YES ☒ NO

☒ GRAVITY ☐ PRESSURE

☒ Residence No. Bedrooms 5

☐ Business No. Persons

☐ Other No. Employees

☒ Slab ☐ Crawl Space

☐ Basement w/plumbing ☐ Basement w/o plumbing

Water Supply

☐ Private

☐ Public

☒ Community


Comments / Conditions:

INITIAL SITE SKETCH

SEE PLAN FROM BATEMAN CIVIL SURVEY CO.

APPROVED BY ICHD

AS BUILT SKETCH

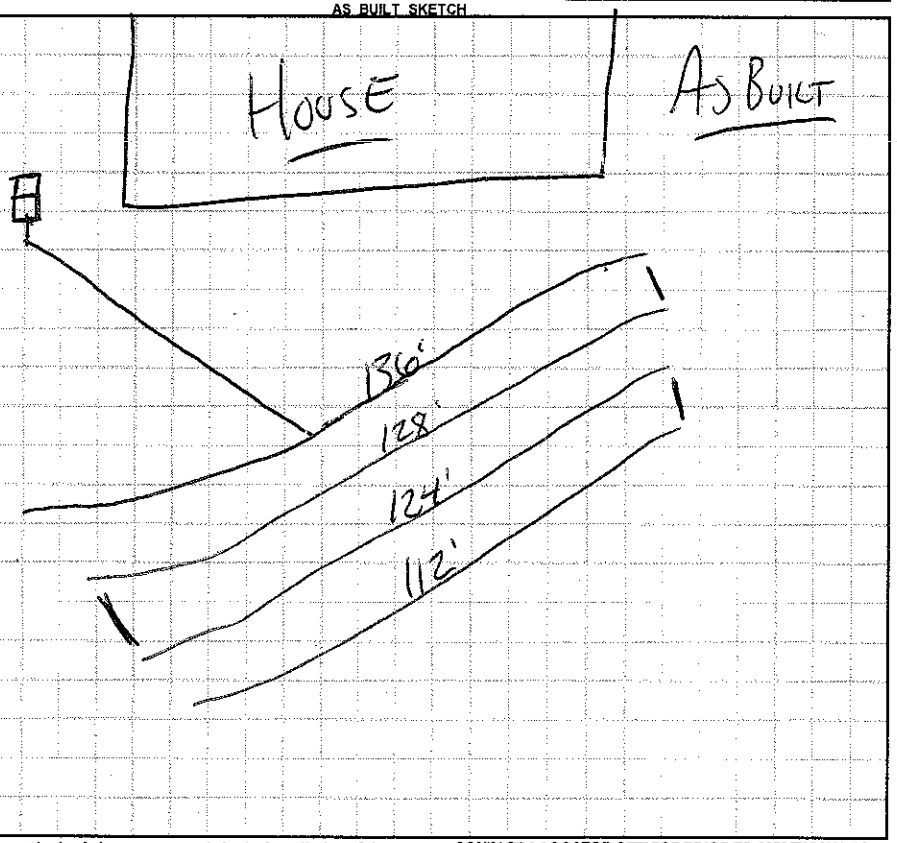

Permit can be suspended or revoked if any false information is supplied toward securing the permit / any unauthorized changes are made to the site / any unauthorized changes are made in the installation of the system. **CONTACT A LOCATOR SERVICE PRIOR TO ANY EXCAVATION**

☐ **IMPROVEMENT PERMIT** *with plat valid without expiration.* ☒ **IMPROVEMENT PERMIT** *with site plan valid for 60 mos.* ☐ **AUTHORIZATION TO CONSTRUCT** *valid for period equal to IMPROVEMENT PERMIT--not to exceed 60 mo.*

Owner / Applicant Signature: Date: 12-4-13 Installed by: CPC

IMPROVEMENT PERMIT by: Date: 11-22-13 OPERATION PERMIT by: Date: CHECKED JUN 10 2014

AUTHORIZATION TO CONSTRUCT by: Date: 4-10-14 Existing System Inspected by: Date:

Health Dept. Copy - WHITE Applicant (Final Approval) - YELLOW Applicant (Conditional Approval) - PINK