IREDELL COUNTY HEALTH DEPARTMENT

Statesville Office (704) 878-5305 Mooresville Office (704) 660-3625 PERMIT # 20689

IMPROVEMENT PERMIT / AUTHORIZATION TO CONSTRUCT / OPERATION PERMIT / EXISTING SYSTEM

PIN # 4639-95-6007

APPLICANT: Gerald Wilson APPLICANT ADDRESS: 113 Leaning Tower Dr Mooresville NC

SITE ADDRESS: 113 Leaning Tower Dr PHONE: 678-943-4016 ALT. PHONE:

SITE DIRECTIONS: Hwy 150W, TR on Perth Rd, TL on Bells Crossing, TR on N. San Agustine Dr, TL on Leaning Tower, Lot on L

SUBDIVISION: Bells Crossing SECTION: 2 LOT # 47 LOT AREA: 0.82ac DESIGN FLOW: 600 gpd L.T.A.R.: 0.7

Septic Tank 1500 EXIST (gal) STB Date

Pump Tank (gal) PT Date

Pump Make Model Serial #

Nitrification Fields 1 # Lines 5 EXISTING Linear Ft:

Trench Width Max. Trench Bottom Depth Gravel Depth

☐ New System ☐ Repair ☐ Expansion System Type: I II III IV V VI

System Description: EXISTING GRAVITY 25% REDUC

Repair System Description: LP PPBPS

Maintenance Agreement Required: ☐ YES ☑ NO

☑ GRAVITY ☐ PRESSURE

☐ Residence No. Bedrooms 5

☐ Business No. Persons 10

☑ Other No. Employees

☐ Slab ☐ Crawl Space


☐ Basement w/plumbing ☐ Basement w/o plumbing

Water Supply: ☐ Private ☐ Public ☒ Community


Comments / Conditions: This permit for addition of a garage and pergola.

INITIAL SITE SKETCH

1" = 40'

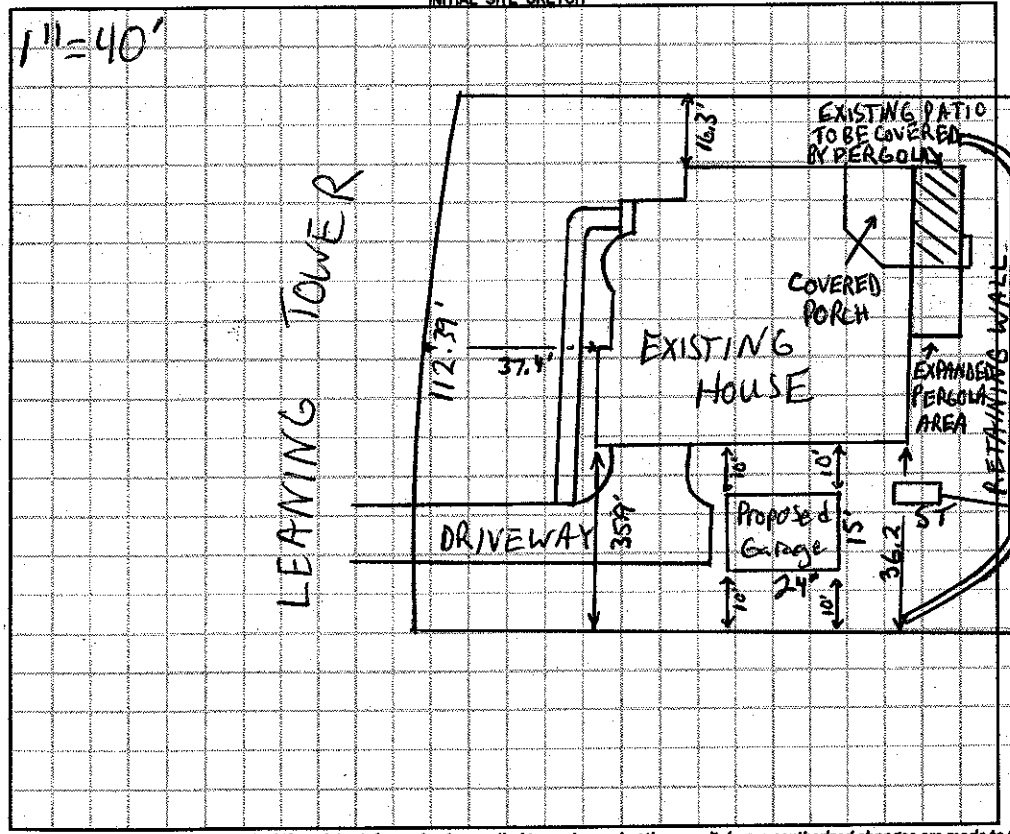

AS BUILT SKETCH

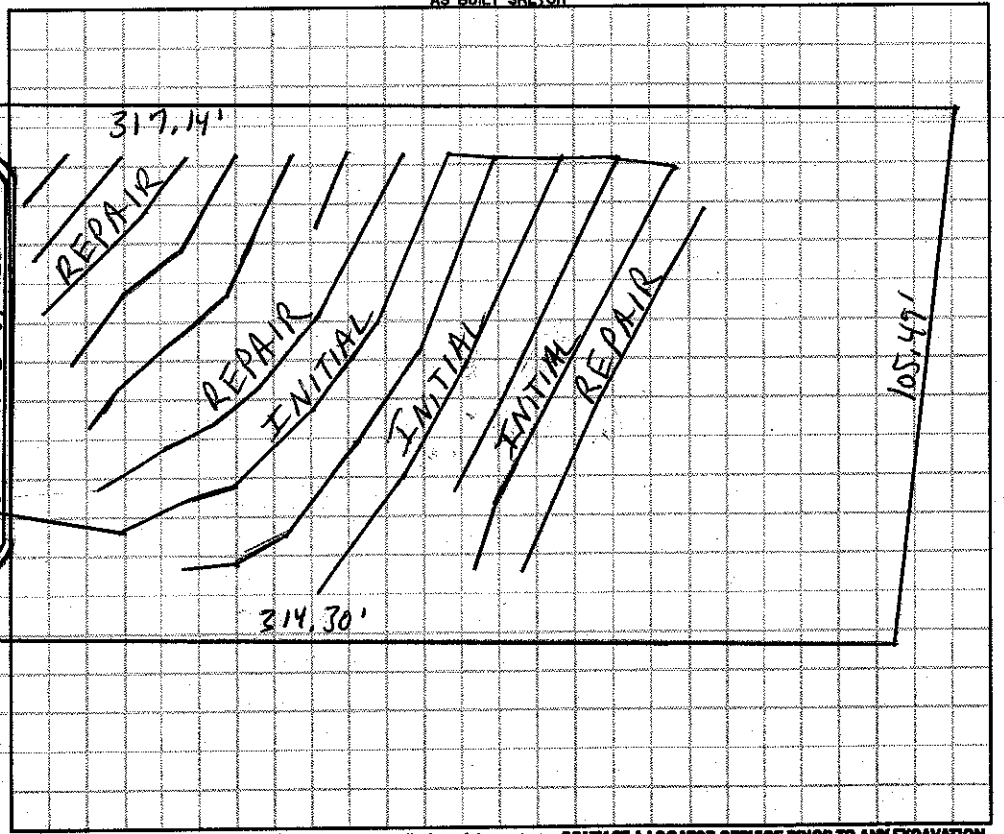

Permit can be suspended or revoked if any false information is supplied toward securing the permit / any unauthorized changes are made to the site / any unauthorized changes are made in the installation of the system. **CONTACT A LOCATOR SERVICE PRIOR TO ANY EXCAVATION**

☐ **IMPROVEMENT PERMIT** *with plat valid without expiration.* ☐ **IMPROVEMENT PERMIT** *with site plan valid for 60 mos.* ☐ **AUTHORIZATION TO CONSTRUCT** *valid for period equal to IMPROVEMENT PERMIT--not to exceed 60 mo.*

Owner / Applicant Signature: Date: 1/16/15 Installed by:

IMPROVEMENT PERMIT by: Date: OPERATION PERMIT by: Date:

AUTHORIZATION TO CONSTRUCT by: Date: Existing System Inspected by: Date: 1-16-15

Health Dept. Copy - WHITE Applicant (Final Approval) - YELLOW Applicant (Conditional Approval) - PINK