3:00 $570

IREDELL COUNTY HEALTH DEPARTMENT

STATESVILLE 704-878-5305 MOORESVILLE 704-664-5281

IMPROVEMENT PERMIT / AUTHORIZATION TO CONSTRUCT / OPERATION PERMIT / EXISTING SYSTEM INSPECTION

PERMIT# 116698 PIN# 4639496276.9 4639-96-0895 DATE 5/6/04

OWNER OR CONTRACTOR HONEYSUCKLE CREEK LLC / LAKEMONT HOMES PHONE: Business 400-2344 Home

ADDRESS PO BOX 1463 MATTHEWS NC 28105

LOCATION PERTH (N) - TL on HONEYSUCKLE - ON LT

SUBDIVISION HONEYSUCKLE CK BLOCK / SECTION LOT 9 LOT AREA .6 AC SITE CLASS. PS DESIGN FLOW 360GPD L.T.A.R. .2 GPD/FT2

Septic Tank: 1000 Gallons; STB 794 Date 9/18/04
Pump Tank: 0 Gallons; PT Date
Pump Make: Model Serial No.
Nitrification Field: No Fields 1 Square Feet 640 Linear Feet 320
No Lines 8@40' Trench Width 24" Max Trench Bottom Depth 30"

☑ New System ☐ Repair System Type: I, II, (III), IV, V, VI
System Description: GRAVITY PANEL
Repair System Description: LP PANEL
Maintenance Agreement Required: ☐ Yes ☑ No

☑ House/Mod. Home No. Bedrooms 3
☐ Mobile Home No. Bathrooms 3
☐ Business No. Employees
☐ Other


Water Supply: ☑ Individual ☐ Public ☐ Community

Gravel Depth NA ☐ Slab ☑ Crawl Space ☐ Basement w/plumbing ☐ Basement wo/plumbing

Comments:/Conditions:

Comments:/Conditions:
install & erosion

INITIAL SITE SKETCH 1" = 50'

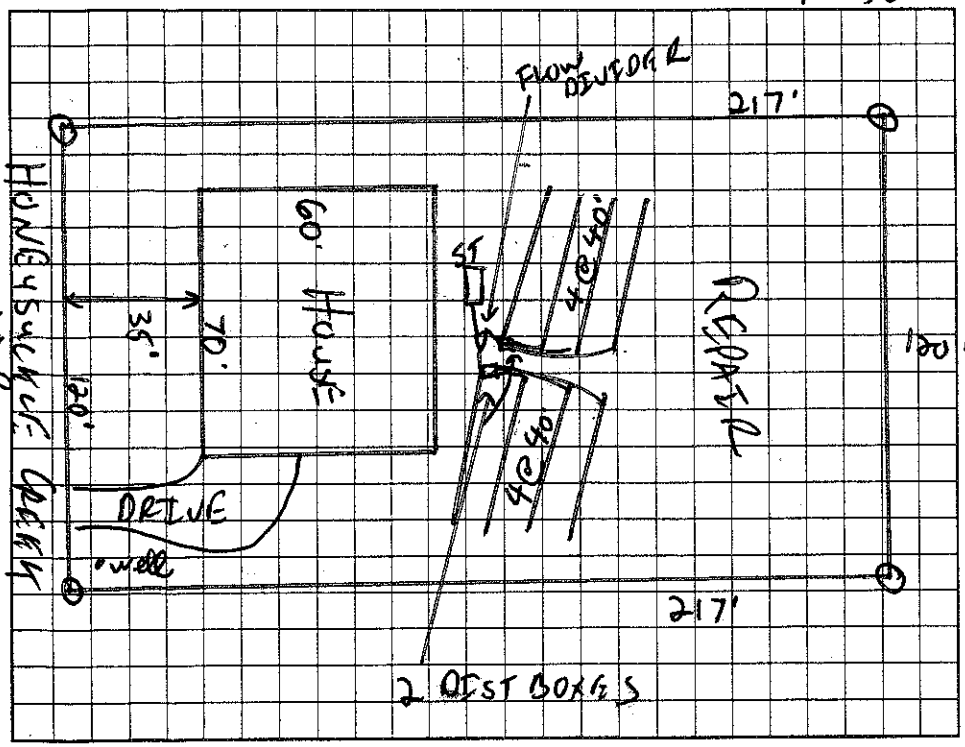

AS BUILT SKETCH

Permit can be suspended or revoked if any false information is supplied toward securing the permit/any unauthorized changes are made to the site/any unauthorized changes are made in the installation of the system. Improvement Permit with plat valid without expiration. Improvement Permit with site plan valid for sixty months. Authorization to Construct is valid for a period equal to that of Improvement Permit – not to exceed sixty months.

Signed: date 5/10/04
Improvement Permit by: C. MS date 5/6/04
Authorization to Construct by: C. MS date 5/6/04

Installed by: Larry Brown Grading
Operation Permit by: Wesley Sprinkle R.S. date 10/21/04
Existing System Inspection by: date

HEALTH DEPT. COPY: WHITE OWNER COPY (FINAL): YELLOW OWNER COPY (INITIAL): PINK