IREDELL COUNTY HEALTH DEPARTMENT

STATESVILLE 704-878-5305 MOORESVILLE 704-664-5281

IMPROVEMENT PERMIT / AUTHORIZATION TO CONSTRUCT / OPERATION PERMIT / EXISTING SYSTEM INSPECTION

PERMIT# 117768 PIN# 4639962769.33 4639-96-1291 DATE 4/2/04

OWNER OR CONTRACTOR HONEYSUCKLE CREEK LLC / Easter Dev. PHONE: Business 201-6465 Home

ADDRESS 227 HIDEAWAY LN MOORESVILLE NC 28117

LOCATION PERTH (N) - TL 1ST HONEYSUCKLE - ON LT

SUBDIVISION HONEYSUCKLE CREEK BLOCK / SECTION LOT 33 LOT AREA 1.47AC SITE CLASS. RS DESIGN FLOW 480GAD L.T.A.R. .25 660/FT

Septic Tank: 1000 Gallons; STB 825 Date 11/5/05

Pump Tank: 1000 Gallons; PT 304 Date 12/5/05

Pump Make: ZOELLER Model N 46-C Serial No. 11266

Nitrification Field: No Fields 1 Square Feet 640 Linear Feet 320

No Lines 4 @ 80' Trench Width 24" Max Trench Bottom Depth 36" Gravel Depth

☑ New System ☐ Repair System Type: I, II, III, IV, V, VI

System Description: CP PANEL

Repair System Description: SAME

Maintenance Agreement Required: ☑ Yes ☐ No

☑ House/Mod. Home No. Bedrooms 4

☐ Mobile Home No. Bathrooms 4

☐ Business No. Employees

☐ Other

☐ Slab ☐ Crawl Space ☑ Basement w/plumbing ☐ Basement wo/plumbing

Water Supply: ☑ Individual ☐ Public ☐ Community


Comments:/Conditions:

1) GULLEY TO BE CLEANED OUT AND FILLED WITH DEBRIS FREE RED CLAY SOIL.


2) SOLID PIPE ACROSS GULLEY - LINEAR FOOTAGE DOES NOT COUNT WHERE SOLID PIPED ACROSS GULLEY.

Comments:/Conditions:

INITIAL SITE SKETCH 1"=50'

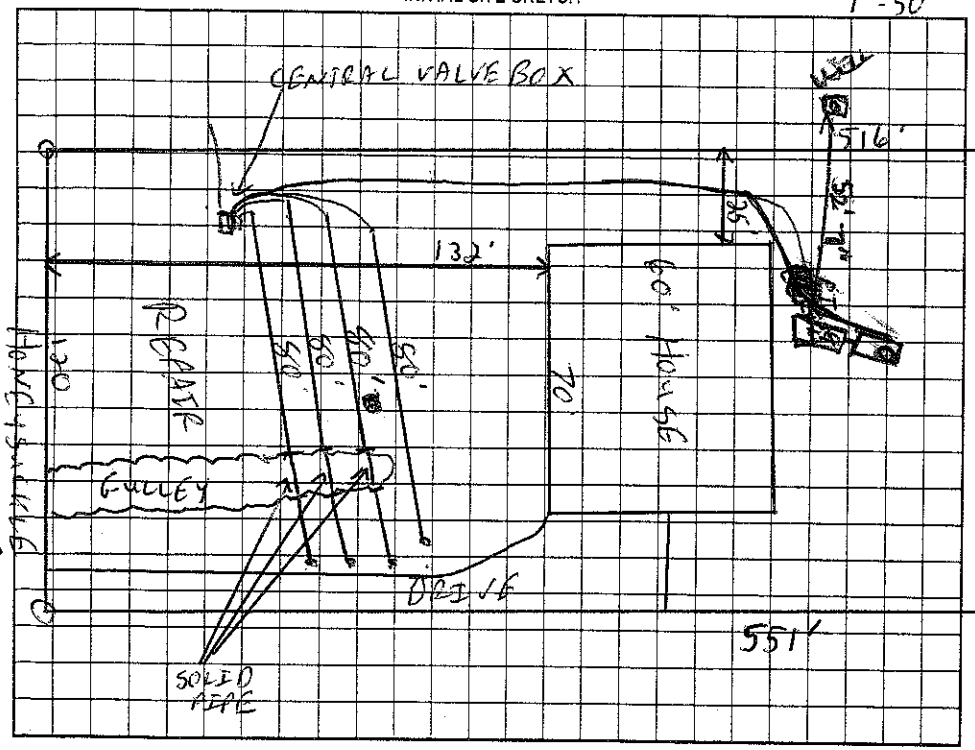

AS BUILT SKETCH

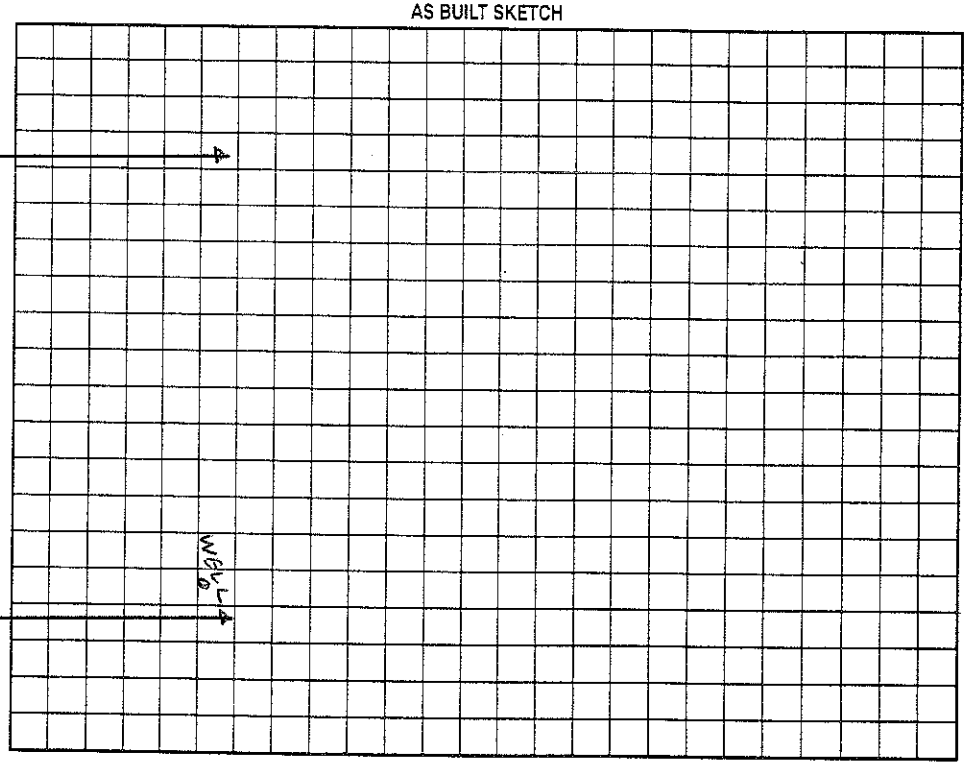

Permit can be suspended or revoked if any false information is supplied toward securing the permit/any unauthorized changes are made to the site/any unauthorized changes are made in the installation of the system. Improvement Permit with plat valid without expiration. Improvement Permit with site plan valid for sixty months. Authorization to Construct is valid for a period equal to that of Improvement Permit – not to exceed sixty months.

Signed: date 7-28-04 Installed by: Rowan Septic Tank

Improvement Permit by: RS date 4/2/04 Operation Permit by: Wesley Sparks RS. date 3/13/06

Authorization to Construct by: RS date 6/21/05 Existing System Inspection by: date

HEALTH DEPT. COPY: WHITE OWNER COPY (FINAL): YELLOW OWNER COPY (INITIAL): PINK