IREDELL COUNTY HEALTH DEPARTMENT

STATESVILLE 704-878-5305 MOORESVILLE 704-664-5281

IMPROVEMENT PERMIT / AUTHORIZATION TO CONSTRUCT / OPERATION PERMIT / EXISTING SYSTEM INSPECTION

PERMIT# 117782 PIN# 4639 96 2769.46 4639-96-2634 DATE 7/20/04

OWNER OR CONTRACTOR HONEYSUCKLE CREEK LLC / LEWIS CARPENTER PHONE: Business 201-6465 Home

ADDRESS 227 HIDEAWAY LN MOORESVILLE NC 28117

LOCATION PERTH (N) - TL 1ST HONEYSUCKLE - ON RT

SUBDIVISION HONEYSUCKLE CREEK BLOCK / SECTION LOT 46 LOT AREA .64c SITE CLASS. PS DESIGN FLOW 460GPD L.T.A.R. 1.36-A0/LOT

Septic Tank: 1000 Gallons; STB 3/2 Date 8/26/06
Pump Tank: 1000 Gallons; PT 2/1 Date 8/27/04
Pump Make: Gould's Model WJS 0.5/24 Serial No.
Nitrification Field: No Fields 1 Square Feet 1200 Linear Feet 400
No Lines 5@80' Trench Width 36" Max Trench Bottom Depth 36" Gravel Depth N/A

☑ New System ☐ Repair System Type: I, II, III, IV, V, VI
System Description: PUMP 25% REDUCTION
Repair System Description: LP PANEL
Maintenance Agreement Required: ☐ Yes ☑ No


☑ House/Mod. Home No. Bedrooms 4
☐ Mobile Home No. Bathrooms 4
☐ Business No. Employees
☐ Other
☐ Slab ☑ Crawl Space ☐ Basement w/plumbing ☐ Basement wo/plumbing

Water Supply: ☑ Individual ☐ Public ☐ Community

Comments:/Conditions: Drainlines, tanks & pressure checked 10/3/06 by SM

Comments:/Conditions:

INITIAL SITE SKETCH 1"=50'

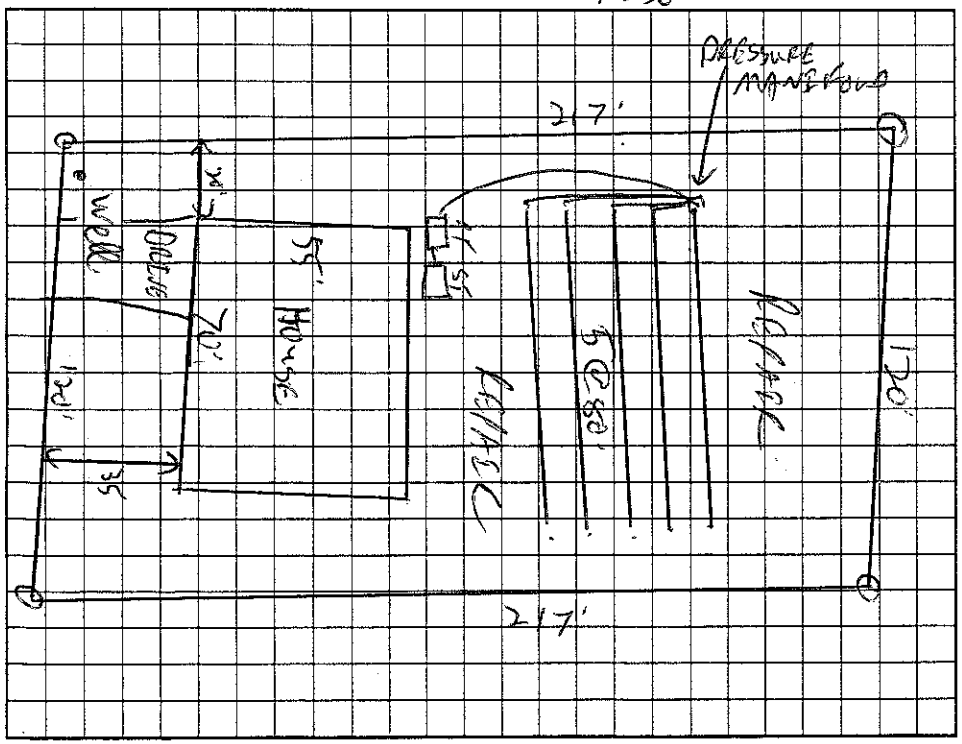

AS BUILT SKETCH

Installed Quick 4

Permit can be suspended or revoked if any false information is supplied toward securing the permit/any unauthorized changes are made to the site/any unauthorized changes are made in the installation of the system. Improvement Permit with plat valid without expiration. Improvement Permit with site plan valid for sixty months. Authorization to Construct is valid for a period equal to that of Improvement Permit – not to exceed sixty months.

Signed: [signature] mrg date 7-28-04
Improvement Permit by: [signature] RS date 7/26/04
Authorization to Construct by: Wesley Sparks RS date 10/5/05
Installed by: Larry Beam RS
Operation Permit by: [signature] date 10/24/06
Existing System Inspection by: date

HEALTH DEPT. COPY: WHITE OWNER COPY (FINAL): YELLOW OWNER COPY (INITIAL): PINK