IREDELL COUNTY HEALTH DEPARTMENT

STATESVILLE 704-878-5305 MOORESVILLE 704-664-5281

IMPROVEMENT PERMIT / AUTHORIZATION TO CONSTRUCT / OPERATION PERMIT / EXISTING SYSTEM INSPECTION

PERMIT# ~~[illegible]~~ 116692 PIN# ~~4639796276 9 8~~ 4639-96-2821 DATE 4/6/04

OWNER OR CONTRACTOR HONEYSUCKLE CREEK LLC/MICHAEL HARPER PHONE: Business 201-6465 Home

ADDRESS 237 HIDEAWAY LN MOORESVILLE NC 28117

LOCATION PERTH (N) - TL 2nd HONEYSUCKLE - ON LT

SUBDIVISION HONEYSUCKLE CREEK BLOCK / SECTION LOT 8 LOT AREA ~~[illegible]~~ .91AC SITE CLASS. PS DESIGN FLOW 400.00 L.T.A.R. .36.00/FT²

Septic Tank: 1000 Gallons; STB 794 Date 3/5/05
Pump Tank: Gallons; PT Date
Pump Make: Model Serial No.
Nitrification Field: No Fields 1 Square Feet 1200 Linear Feet 400
No Lines 4 Trench Width 36" Max Trench Bottom Depth 36" Gravel Depth N/A

☑ New System ☐ Repair System Type: I, II, III, IV, V, VI
System Description: GRAVITY 25% REDUCTION
Repair System Description: LP PANEL
Maintenance Agreement Required: ☐ Yes ☑ No


☑ House/Mod. Home No. Bedrooms 4
☐ Mobile Home No. Bathrooms 4
☐ Business No. Employees
☐ Other

☐ Slab ☑ Crawl Space ☐ Basement w/plumbing ☐ Basement wo/plumbing

Water Supply: ☑ Individual ☐ Public ☐ Community


Comments/Conditions: SYSTEM MAY BE PUMPED IF GRAVITY CANNOT BE ACHIEVED.

INITIAL SITE SKETCH 1"=50'

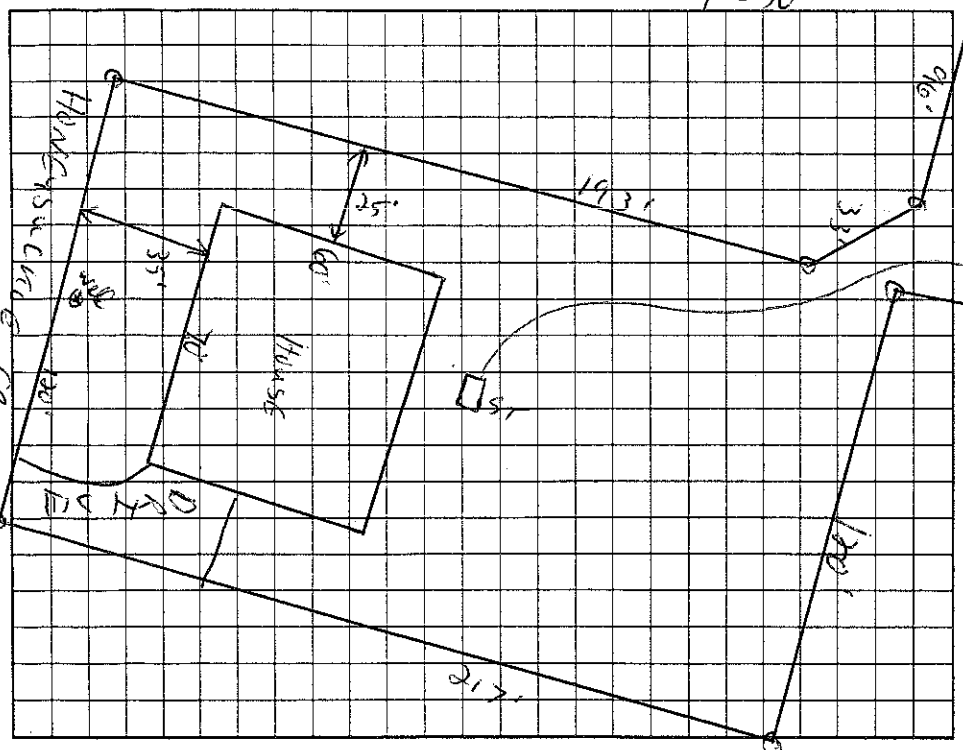

Comments/Conditions:

AS BUILT SKETCH

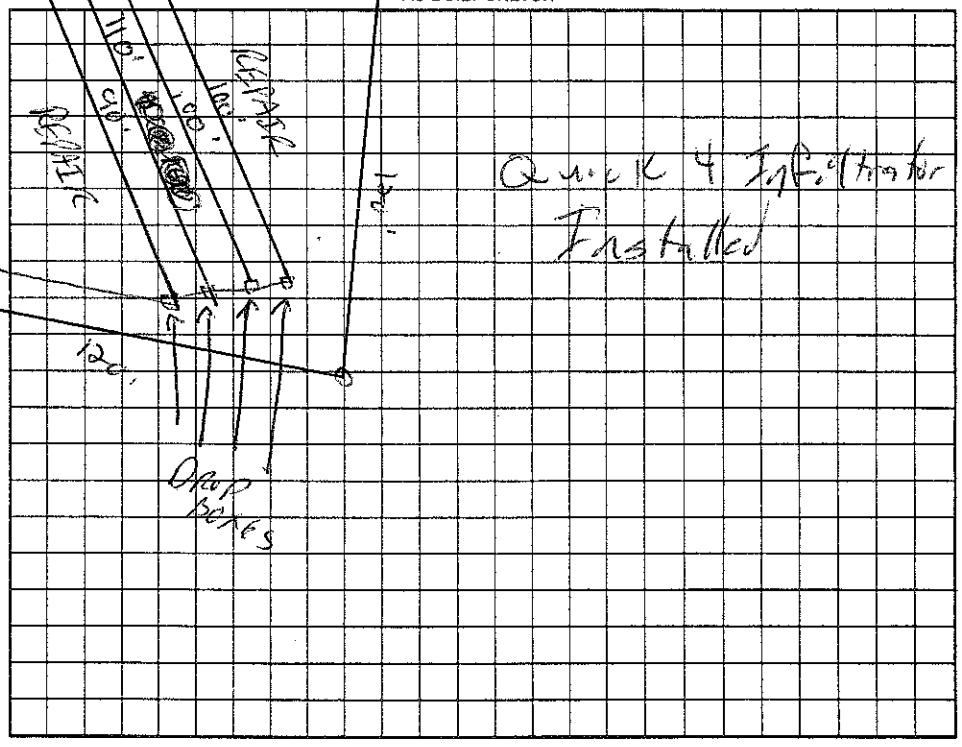

Permit can be suspended or revoked if any false information is supplied toward securing the permit/any unauthorized changes are made to the site/any unauthorized changes are made in the installation of the system. Improvement Permit with plat valid without expiration. Improvement Permit with site plan valid for sixty months. Authorization to Construct is valid for a period equal to that of Improvement Permit – not to exceed sixty months.

Signed: date 4-23-04 Installed by: Larry Beam

Improvement Permit by: RS date 4/6/04 Operation Permit by: RS date 5/25/05

Authorization to Construct by: Wesley Sparks RS. date 12/3/04 Existing System Inspection by: date

HEALTH DEPT. COPY: WHITE OWNER COPY (FINAL): YELLOW OWNER COPY (INITIAL): PINK