IREDELL COUNTY HEALTH DEPARTMENT

STATESVILLE 704-878-5305 MOORESVILLE 704-664-5281

IMPROVEMENT PERMIT / AUTHORIZATION TO CONSTRUCT / OPERATION PERMIT / EXISTING SYSTEM INSPECTION

PERMIT# 117769 PIN# 4639-96-2769, 34 4639-96-3215 DATE 4/2/04

OWNER OR CONTRACTOR HONEYSUCKLE CREEK LLC / TEGLAND - BROWN PHONE: Business 201-6465 Home

ADDRESS 227 HIDEAWAY LN MOORESVILLE NC 28117

LOCATION PERTH (N) - TL HONEYSUCKLE CR. LOOP - ON LT.

SUBDIVISION HONEYSUCKLE CREEK BLOCK / SECTION LOT 34 LOT AREA 1.39AC SITE CLASS. PS DESIGN FLOW 480GPD L.T.A.R. .36 10/R12

Septic Tank: 1000 Gallons; STB 794 Date 6/6/05
Pump Tank: 1000 Gallons; PT 27 Date 10/4/05
Pump Make: LITH-GIANT Model 9EH Serial No.
Nitrification Field: No Fields 1 Square Feet 540 Linear Feet 270
No Lines 3@60@45' Trench Width 24" Max Trench Bottom Depth 36" Gravel Depth N/A

☒ New System ☐ Repair System Type: I, II, (III), IV, V, VI
System Description: PUMP PANEL
Repair System Description: 8 L PPANEL
Maintenance Agreement Required: ☐ Yes ☒ No

~~☐~~ House/Mod. Home No. Bedrooms 4
☐ Mobile Home No. Bathrooms 4
☐ Business No. Employees
☐ Other


☐ Slab ☐ Crawl Space ☒ Basement w/plumbing ☐ Basement wo/plumbing

Water Supply: ~~☐~~ Individual ☐ Public ☐ Community


Comments:/Conditions:

Comments:/Conditions:

INITIAL SITE SKETCH 1" = 50'

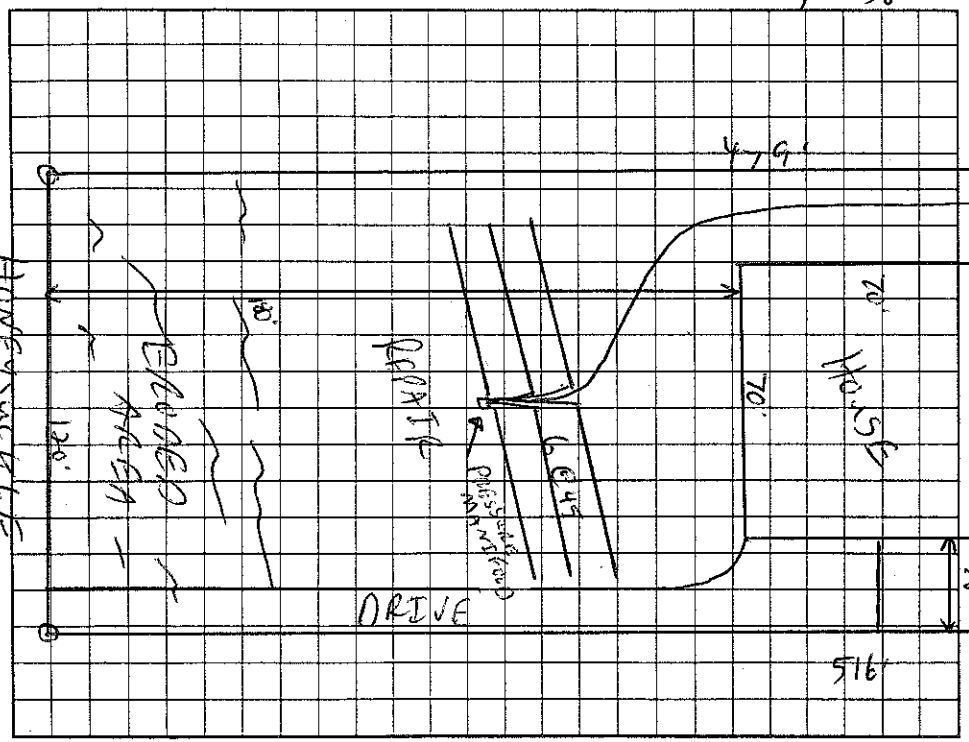

AS BUILT SKETCH

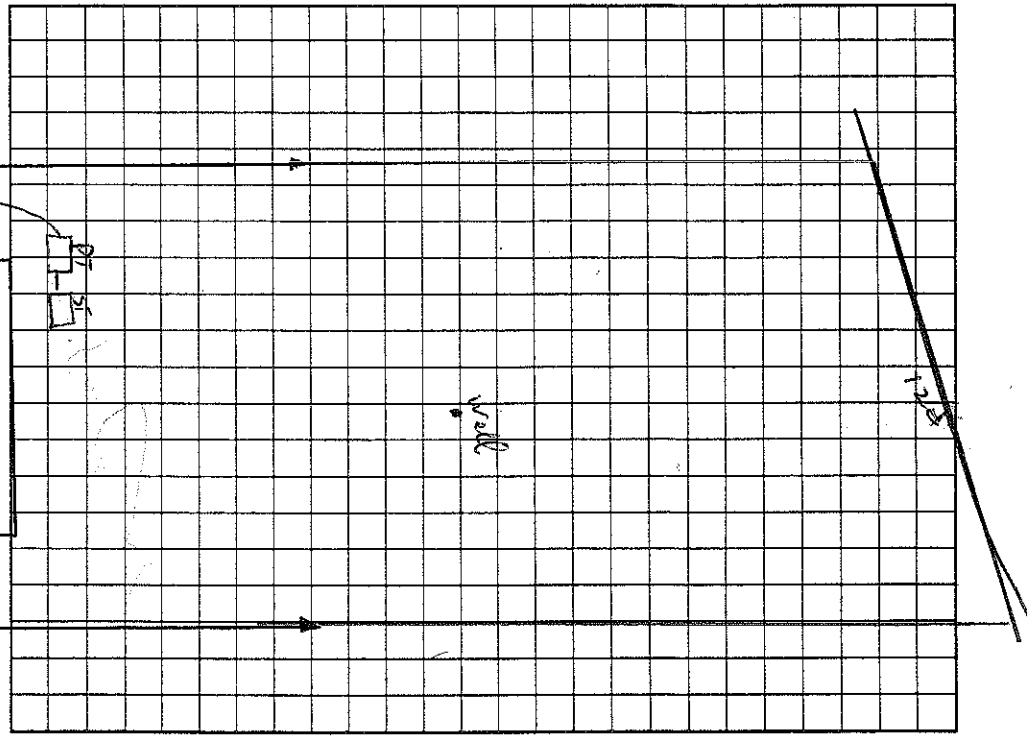

Permit can be suspended or revoked if any false information is supplied toward securing the permit/any unauthorized changes are made to the site/any unauthorized changes are made in the installation of the system. Improvement Permit with plat valid without expiration. Improvement Permit with site plan valid for sixty months. Authorization to Construct is valid for a period equal to that of Improvement Permit – not to exceed sixty months.

Signed: [signature] - mrg date 7-28-04 Installed by: Abernathy

Improvement Permit by: [signature] RS date 4/2/04 Operation Permit by: [signature] RS date 12/13/05

Authorization to Construct by: Wesley Sparks R.S. date 4/4/05 Existing System Inspection by: date

HEALTH DEPT. COPY: WHITE OWNER COPY (FINAL): YELLOW OWNER COPY (INITIAL): PINK