IREDELL COUNTY HEALTH DEPARTMENT

STATESVILLE 704-878-5305 MOORESVILLE 704-664-5281

IMPROVEMENT PERMIT / AUTHORIZATION TO CONSTRUCT / OPERATION PERMIT / EXISTING SYSTEM INSPECTION

PERMIT# 117779 PIN# 4639967769.43 4639-96-5697 DATE 7/20/04

OWNER OR CONTRACTOR Honeysuckle Creek LLC / Toland Brown Const PHONE: Business 201-6465 Home

ADDRESS 227 Hazy Away Ln Mooresville NC 28117

LOCATION Perth - North - TL 1st Honeysuckle - on RT

SUBDIVISION Honeysuckle Creek BLOCK / SECTION LOT 43 LOT AREA .6 AC SITE CLASS. RS DESIGN FLOW 480GPD L.T.A.R. .25GPD/Ft

Septic Tank: 1000 Gallons: STB 794 Date 10/21/05

Pump Tank: 1000 Gallons: PT 788 Date 11/3/05

Pump Make: Little Giant Model 9E-FH Serial No.

Nitrification Field: No Fields 1 Square Feet 1480 Linear Feet 490

No Lines 5 Trench Width 36" Max Trench Bottom Depth 36" Gravel Depth NA

☑ New System ☐ Repair System Type: I, II, III, IV, V, VI

System Description: Pump & 5% Reduction

Repair System Description: LP Panel

Maintenance Agreement Required: ☐ Yes ☑ No

☐ House/Mod. Home No. Bedrooms 4

☐ Mobile Home No. Bathrooms 4

☐ Business No. Employees

☐ Other


☐ Slab ☐ Crawl Space ☑ Basement w/plumbing ☐ Basement wo/plumbing

Water Supply: ☑ Individual ☐ Public ☐ Community

Comments:/Conditions:

Comments:/Conditions: Pressure, elect & alarm 3/6/06 mc
Tanks & lines checked 11/7/05 BM

INITIAL SITE SKETCH 1"=50'

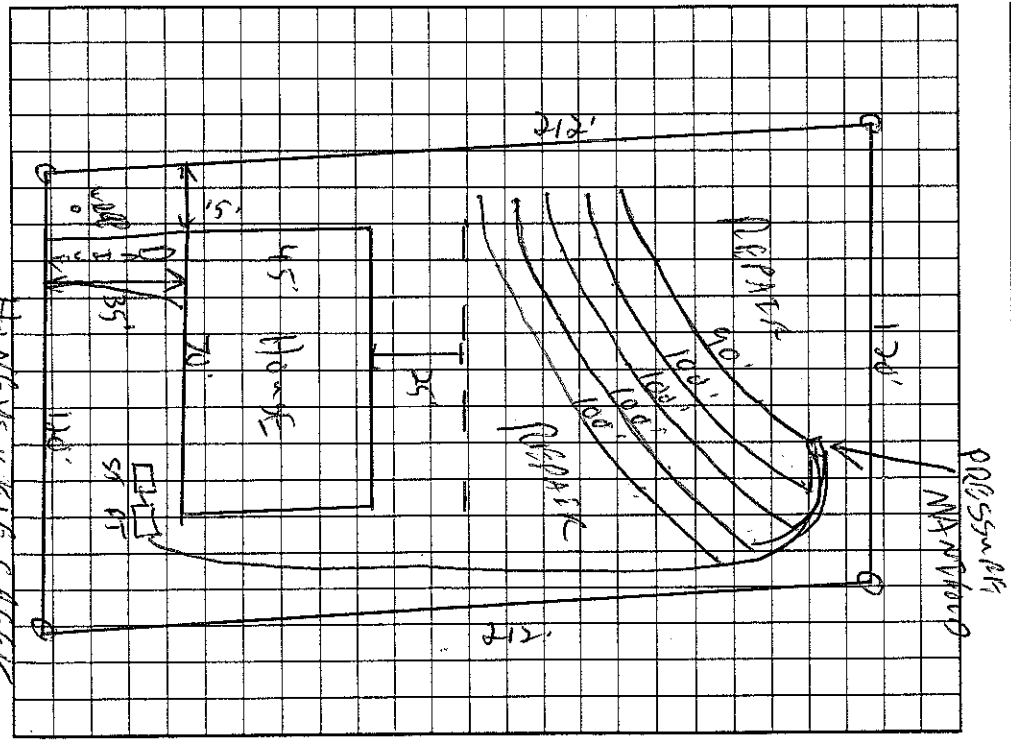

AS BUILT SKETCH

Used Quick 4 For Drainfield

Permit can be suspended or revoked if any false information is supplied toward securing the permit/any unauthorized changes are made to the site/any unauthorized changes are made in the installation of the system. Improvement Permit with plat valid without expiration. Improvement Permit with site plan valid for sixty months. Authorization to Construct is valid for a period equal to that of Improvement Permit – not to exceed sixty months.

Signed: mrg date 7-28-04 Installed by: Abernathy

Improvement Permit by: RS date 4/20/04 Operation Permit by: Maint. Tech Dotson RS date 3/6/06

Authorization to Construct by: RS date 4/14/05 Existing System Inspection by: date

HEALTH DEPT. COPY: WHITE OWNER COPY (FINAL): YELLOW OWNER COPY (INITIAL): PINK