IREDELL COUNTY HEALTH DEPARTMENT

STATESVILLE 704-878-5305 MOORESVILLE 704-664-5281

IMPROVEMENT PERMIT / AUTHORIZATION TO CONSTRUCT / OPERATION PERMIT / EXISTING SYSTEM INSPECTION

PERMIT# 17773 PIN# 4639 96 2769. 37 4639-96-7480 DATE 4/6/04

OWNER OR CONTRACTOR HONEYSUCKLE CREEK LLC/TEGLUND BROWN PHONE: Business 201-6465 Home

ADDRESS 227 HIDEAWAY LN MOORESVILLE, NC 28117

LOCATION PERTH (N) - TL 1ST HONEYSUCKLE - 2ND LOT ON RT - SEPTIC ON RT ACROSS STREET

SUBDIVISION HONEYSUCKLE CREEK BLOCK / SECTION LOT 37/37A LOT AREA 1.3AC + .3AC SITE CLASS. PS DESIGN FLOW 480GPD L.T.A.R. .36 PD/FT2

Septic Tank: 1000 Gallons; STB 826 Date 12/2/05

Pump Tank: 1000 Gallons; PT 300 Date 8/13/05

Pump Make: GOULDS Model 15 12 14 Serial No.

Nitrification Field: No Fields 1 Square Feet 1200 Linear Feet 400

No Lines 4@100' Trench Width 36" Max Trench Bottom Depth 36" Gravel Depth N/A

☑ New System ☐ Repair System Type: I, II, (III), IV, V, VI

System Description: PUMP OFFSITE 25% REDUCTION

Repair System Description: LP PANEL OFFSITE

Maintenance Agreement Required: ☐ Yes ☑ No

☑ House/Mod. Home No. Bedrooms 4

☐ Mobile Home No. Bathrooms 4

☐ Business No. Employees

☐ Other


☐ Slab ☐ Crawl Space ☑ Basement w/plumbing ☐ Basement wo/plumbing

Water Supply: ☑ Individual ☐ Public ☐ Community


Comments:/Conditions: SEE MASTER PLAT FOR SUPPLY LINE EASEMENTS
Well ~ 125' to left Property line.
Reviewed building plans 5/18/05 MZ

Comments:/Conditions:

INITIAL SITE SKETCH

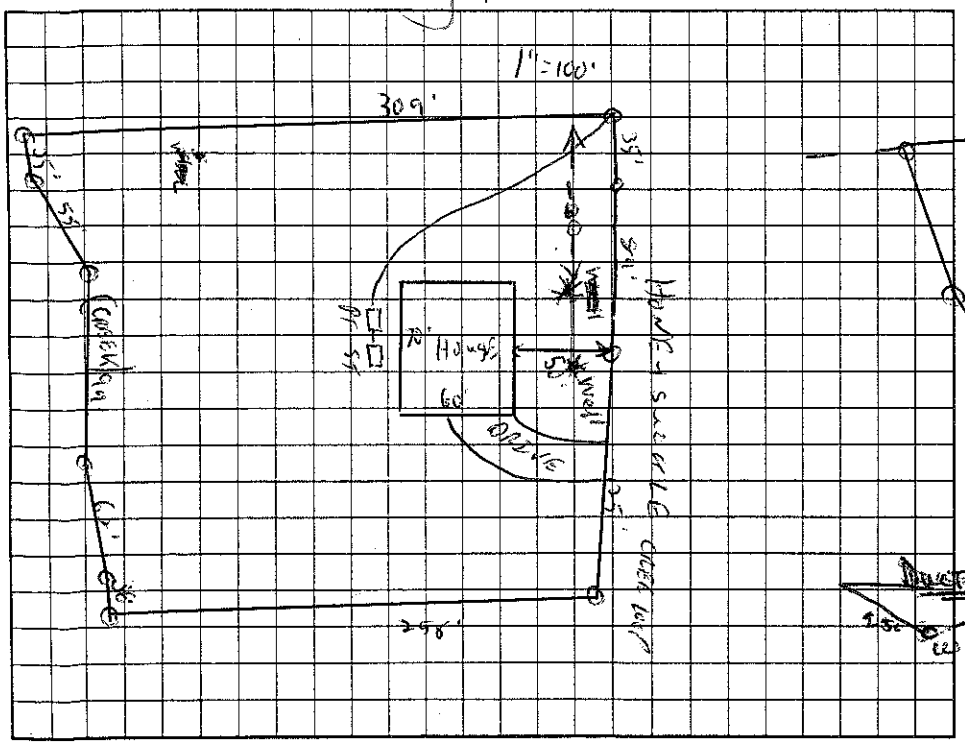

AS BUILT SKETCH

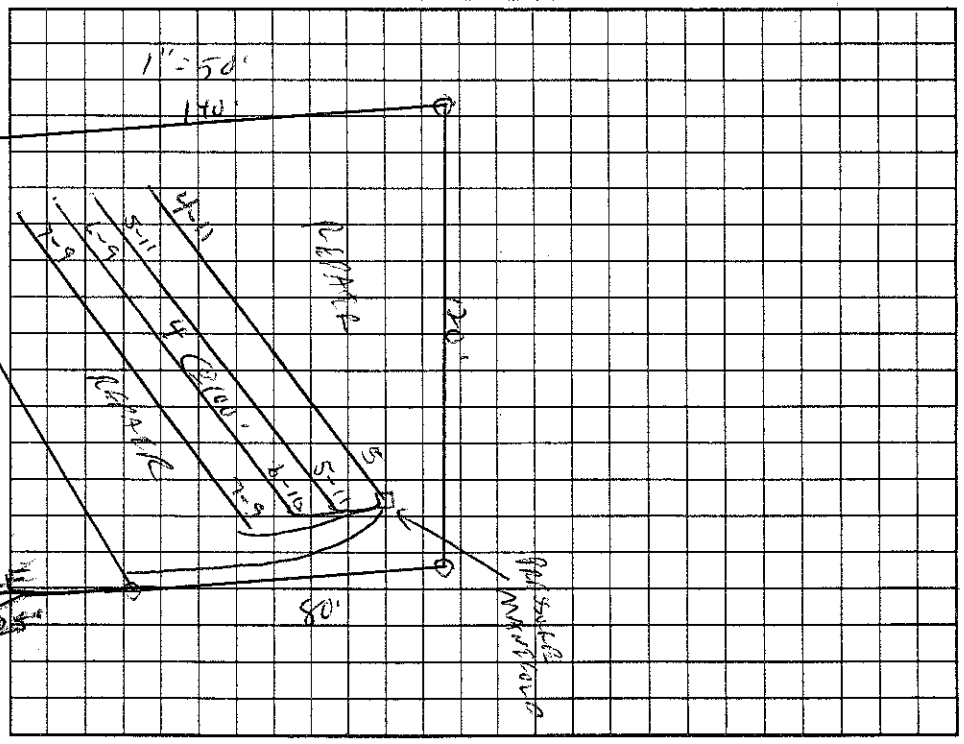

Permit can be suspended or revoked if any false information is supplied toward securing the permit/any unauthorized changes are made to the site/any unauthorized changes are made in the installation of the system. Improvement Permit with plat valid without expiration. Improvement Permit with site plan valid for sixty months. Authorization to Construct is valid for a period equal to that of Improvement Permit – not to exceed sixty months.

Signed: [signature] - mrg date 2-28-04 Installed by: Rowan Septic Tank

Improvement Permit by: [signature] date 4/6/04 Operation Permit by: Wesley Sparks RS. date 2/24/06

Authorization to Construct by: [signature] date 5/18/05 Existing System Inspection by: date

HEALTH DEPT. COPY: WHITE OWNER COPY (FINAL): YELLOW OWNER COPY (INITIAL): PINK