IREDELL COUNTY HEALTH DEPARTMENT

STATESVILLE 878-5305 MOORESVILLE 704-664-5281

IMPROVEMENT PERMIT / AUTHORIZATION TO CONSTRUCT / OPERATION PERMIT / EXISTING SYSTEM INSPECTION

PERMIT# 116685 PIN# 4639962764.4 4639-96-7911 DATE 3/30/04

OWNER OR CONTRACTOR HONEYSUCKLE CREEK LLC / Pride Homes PHONE: Business 201-6465 Home

ADDRESS 227 HICKAWAY LN MOORESVILLE NC 28117

LOCATION PERTH (N) - TL 2nd HONEYSUCKLE - @ SPOON LT

SUBDIVISION HONEYSUCKLE CREEK BLOCK / SECTION LOT 4 LOT AREA .861 .784C SITE CLASS. RS DESIGN FLOW 360GPD L.T.A.R. .1250PD/FT²

Septic Tank: 1000 Gallons; STB 1012 Date 4/9/05

Pump Tank: 1000 Gallons; PT 17 Date 6/26/05

Pump Make: Goulds Model WE05-111 Serial No.

Nitrification Field: No Fields 1 Square Feet 480 Linear Feet 240

No Lines 4 Trench Width 24" Max Trench Bottom Depth 36" Gravel Depth N/A

☑ New System ☐ Repair System Type: I, II, III, (IV), V, VI

System Description: LP PANEL

Repair System Description: SAME

Maintenance Agreement Required: ☑ Yes ☐ No

☑ House/Mod. Home No. Bedrooms 3

☐ Mobile Home No. Bathrooms 3

☐ Business No. Employees

☐ Other

☐ Slab ☐ Crawl Space ☑ Basement w/plumbing ☐ Basement wo/plumbing


Water Supply: ☑ Individual ☐ Public ☐ Community

Comments:/Conditions:

Comments:/Conditions:

54 panels
3/16" holes

INITIAL SITE SKETCH 1"=50'

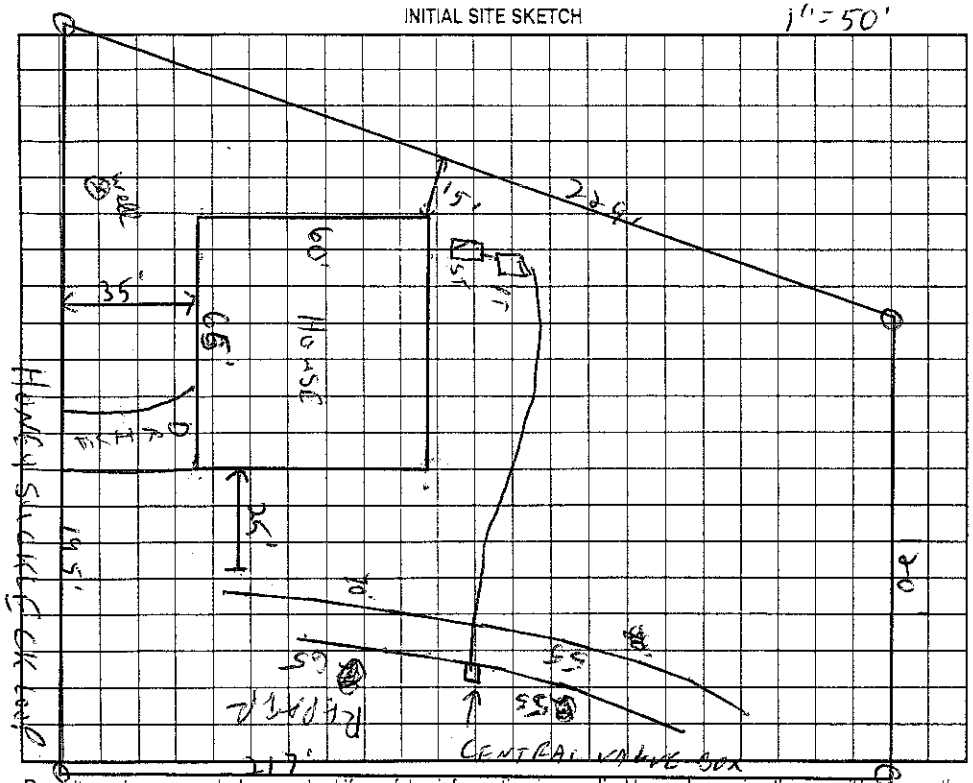

AS BUILT SKETCH

Permit can be suspended or revoked if any false information is supplied toward securing the permit/any unauthorized changes are made to the site/any unauthorized changes are made in the installation of the system. Improvement Permit with plat valid without expiration. Improvement Permit with site plan valid for sixty months. Authorization to Construct is valid for a period equal to that of Improvement Permit -- not to exceed sixty months.

Signed: date 4-2-04 Installed by:

Improvement Permit by: RS date 3/30/04 Operation Permit by: RS date 11/27/06

Authorization to Construct by: Whitney Sparks RS date 5/23/05 Existing System Inspection by: date

HEALTH DEPT. COPY: WHITE OWNER COPY (FINAL): YELLOW OWNER COPY (INITIAL): PINK