IREDELL COUNTY HEALTH DEPARTMENT

STATESVILLE 704-878-5305 MOORESVILLE 704-664-5281

IMPROVEMENT PERMIT / AUTHORIZATION TO CONSTRUCT / OPERATION PERMIT / EXISTING SYSTEM INSPECTION

PERMIT# 11776 PIN# 4639962769.40 4639-96-8649 DATE 4/6/04

OWNER OR CONTRACTOR HONEYSUCKLE CREEK LLC/TEGLAND-BROWN PHONE: Business 201-6465 Home

ADDRESS 227 ~~HONEYSUCK~~ HIDEAWAY LN MOORESVILLE NC 28117

LOCATION PERTH (N) - TL 1ST HONEYSUCKLE - 2ND ON RT

SUBDIVISION HONEYSUCKLE CREEK BLOCK / SECTION LOT 40 LOT AREA .66AC SITE CLASS. PS DESIGN FLOW 480GPD L.T.A.R. 2 600/FT

Septic Tank: 1000 Gallons; STB 825 Date 2/11/05
Pump Tank: 1000 Gallons; PT 302 Date 2/11/05
Pump Make: ZOELLER Model N140 Serial No.
Nitrification Field: No Fields 1 Square Feet 800 Linear Feet 400
No Lines @ 8 @ 50' Trench Width 24" Max Trench Bottom Depth 36" Gravel Depth N/A

☒ New System ☐ Repair System Type: I, II, (III), IV, V, VI
System Description: PUMP PANEL
Repair System Description: LP PANEL
Maintenance Agreement Required: ☐ Yes ☒ No


☒ House/Mod. Home No. Bedrooms 4
☐ Mobile Home No. Bathrooms 4
☐ Business No. Employees
☐ Other
☐ Slab ☒ Crawl Space ☐ Basement w/plumbing ☐ Basement wo/plumbing

Water Supply: ☒ Individual ☐ Public ☐ Community

Comments:/Conditions: DO NOT CUT HOUSE SITE

Comments:/Conditions:

INITIAL SITE SKETCH 1"=50'

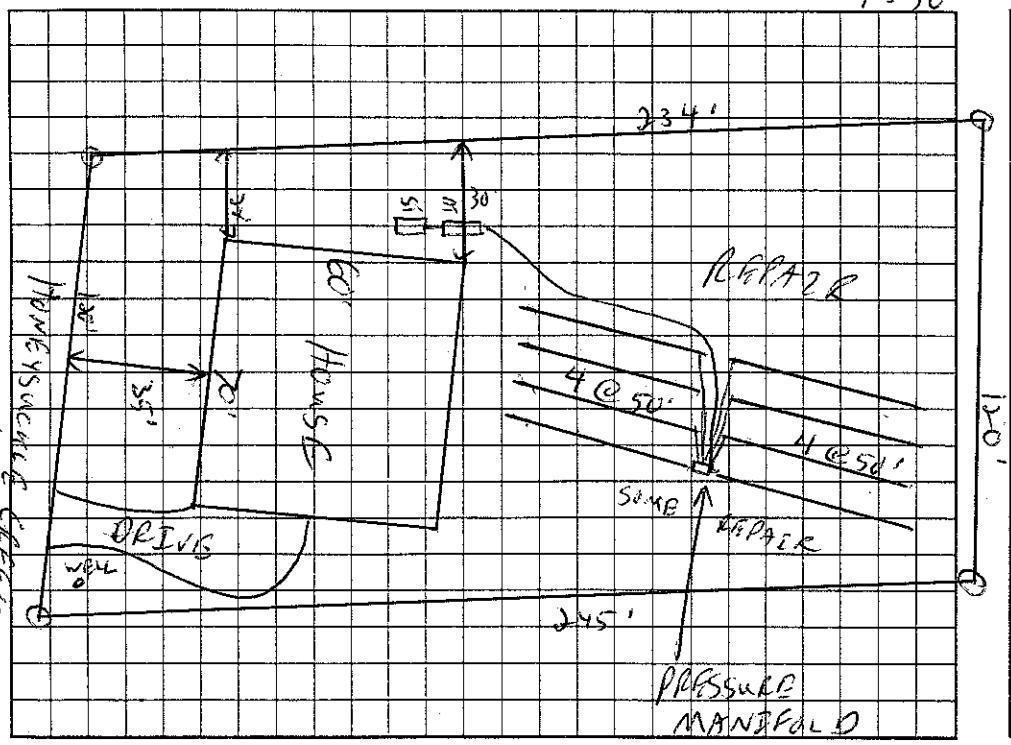

AS BUILT SKETCH

Permit can be suspended or revoked if any false information is supplied toward securing the permit/any unauthorized changes are made to the site/any unauthorized changes are made in the installation of the system. Improvement Permit with plat valid without expiration. Improvement Permit with site plan valid for sixty months. Authorization to Construct is valid for a period equal to that of Improvement Permit – not to exceed sixty months.

Signed: [signature] MRP date 7-28-04 Installed by: Rowan Septic

Improvement Permit by: [signature] RS date 4/6/04 Operation Permit by: [signature] RS date 6/7/06

Authorization to Construct by: [signature] RS date 4/29/05 Existing System Inspection by: date

HEALTH DEPT. COPY: WHITE OWNER COPY (FINAL): YELLOW OWNER COPY (INITIAL): PINK