IREDELL COUNTY HEALTH DEPARTMENT

STATESVILLE 704-878-5305 MOORESVILLE 704-664-5281

IMPROVEMENT PERMIT / AUTHORIZATION TO CONSTRUCT / OPERATION PERMIT / EXISTING SYSTEM INSPECTION

PERMIT# 11668-2 PIN# ~~4639462769.2~~ 4639-96-9945 DATE 3/25/04

OWNER OR CONTRACTOR HONEYSUCKLE CREEK LLC / Pride Homes PHONE: Business 201-6465 Home

ADDRESS 227 HIDEAWAY LN MOORESVILLE NC 28117

LOCATION PERTH (N) - TL 2nd HONEYSUCKLE CREEK - 2nd ON LT

SUBDIVISION HONEYSUCKLE CREEK BLOCK / SECTION LOT 2 LOT AREA .57AC SITE CLASS. PS DESIGN FLOW 480GPD L.T.A.R. .2560PFT2

Septic Tank: 1000 Gallons; STB 1012 Date 3-24-05

Pump Tank: Gallons; PT Date

Pump Make: Model Serial No.

Nitrification Field: No Fields 1 Square Feet 1440 Linear Feet 480

No Lines 4 @ 120' Trench Width 36" Max Trench Bottom Depth 36" Gravel Depth N/A

☑ New System ☐ Repair System Type: I, II, (III), IV, V, VI

System Description: GRAVITY 25% REDUCTION

Repair System Description: LC PANEL

Maintenance Agreement Required: ☐ Yes ☑ No

☑ House/Mod. Home No. Bedrooms 4

☐ Mobile Home No. Bathrooms 4

☐ Business No. Employees

☐ Other


☐ Slab ☑ Crawl Space ☐ Basement w/plumbing ☐ Basement wo/plumbing

Water Supply: ☑ Individual ☐ Public ☐ Community

Comments/Conditions: DO NOT CUT HOUSE P.A.D. KEEP HOUSE ON ORIGINAL GRADE.

Comments/Conditions: Drop Bores

INITIAL SITE SKETCH 1"=50'

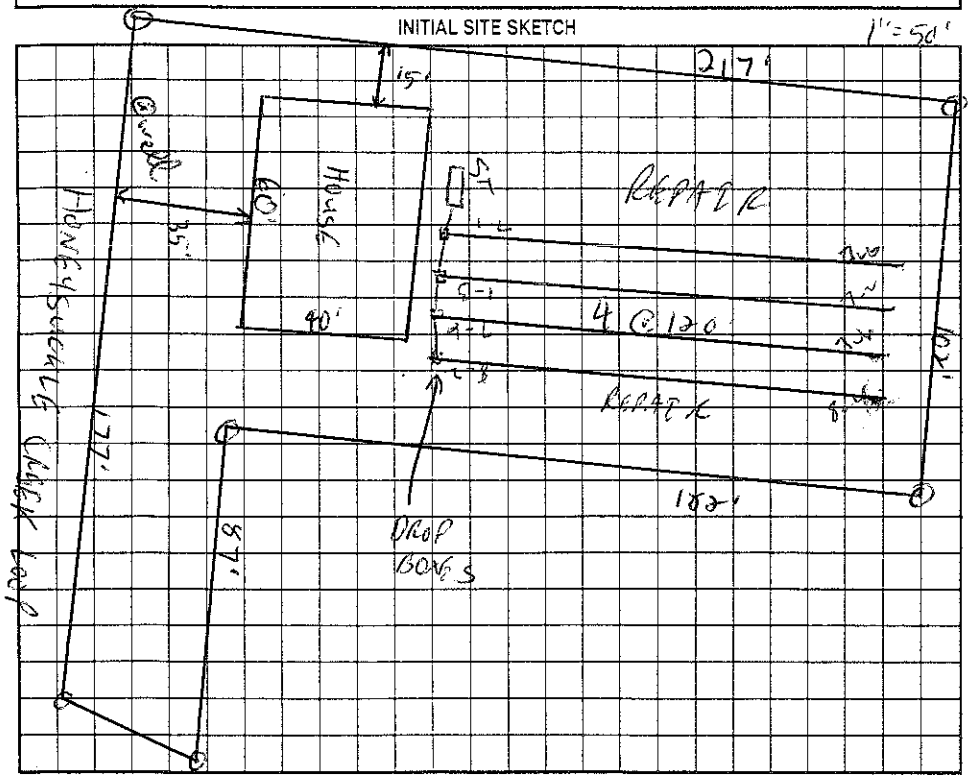

AS BUILT SKETCH

Permit can be suspended or revoked if any false information is supplied toward securing the permit/any unauthorized changes are made to the site/any unauthorized changes are made in the installation of the system. Improvement Permit with plat valid without expiration. Improvement Permit with site plan valid for sixty months. Authorization to Construct is valid for a period equal to that of Improvement Permit – not to exceed sixty months.

Signed date 4-2-04 Installed by: C+S

Improvement Permit by: RS date 3/25/04 Operation Permit by: RS date 11/4/05

Authorization to Construct by: RS date 3/26/05 Existing System Inspection by: date

HEALTH DEPT. COPY: WHITE OWNER COPY (FINAL): YELLOW OWNER COPY (INITIAL): PINK