IREDELL COUNTY HEALTH DEPARTMENT

STATESVILLE 704-878-5305 MOORESVILLE 704-664-5281

IMPROVEMENT PERMIT / AUTHORIZATION TO CONSTRUCT / OPERATION PERMIT / EXISTING SYSTEM INSPECTION

PERMIT# 116732 PIN# 4639 96 2769.19 4639-97-0162 DATE 3/31/04

OWNER OR CONTRACTOR HONEYSUCKLE CREEK LLC PHONE: Business 201-6465 Home

ADDRESS 227 HIDEAWAY LN MOORESVILLE NC 28117

LOCATION PERTH (N) - TL 2nd HONEYSUCKLE - ON RT JUST B-4 CURVE

SUBDIVISION HONEYSUCKLE CREEK BLOCK / SECTION LOT 19 LOT AREA .62AC SITE CLASS. PS DESIGN FLOW 480GPD L.T.A.R. .256-10/FT²

Septic Tank: 1000 Gallons; STB 825 Date 7/27/04
Pump Tank: 1000 Gallons; PT 362 Date 6/16/04
Pump Make: ZOELLER Model N-98-CO3 Serial No. 6F1/04
Nitrification Field: No Fields 1 Square Feet 1440 Linear Feet 450
No Lines 5@96' Trench Width 36" Max Trench Bottom Depth 36" Gravel Depth N/A

☑ New System ☐ Repair System Type: I, II, (III) IV, V, VI
System Description: PUMP 25% REDUCTION
Repair System Description: LP PANEL 300'
Maintenance Agreement Required: ☐ Yes ☑ No

☑ House/Mod. Home No. Bedrooms 4
☐ Mobile Home No. Bathrooms 4
☐ Business No. Employees
☐ Other


☐ Slab ☐ Crawl Space ☑ Basement w/plumbing ☐ Basement wo/plumbing

Water Supply: ☑ Individual ☐ Public ☐ Community

Comments:/Conditions:

Comments:/Conditions:

INITIAL SITE SKETCH 1" = 50'

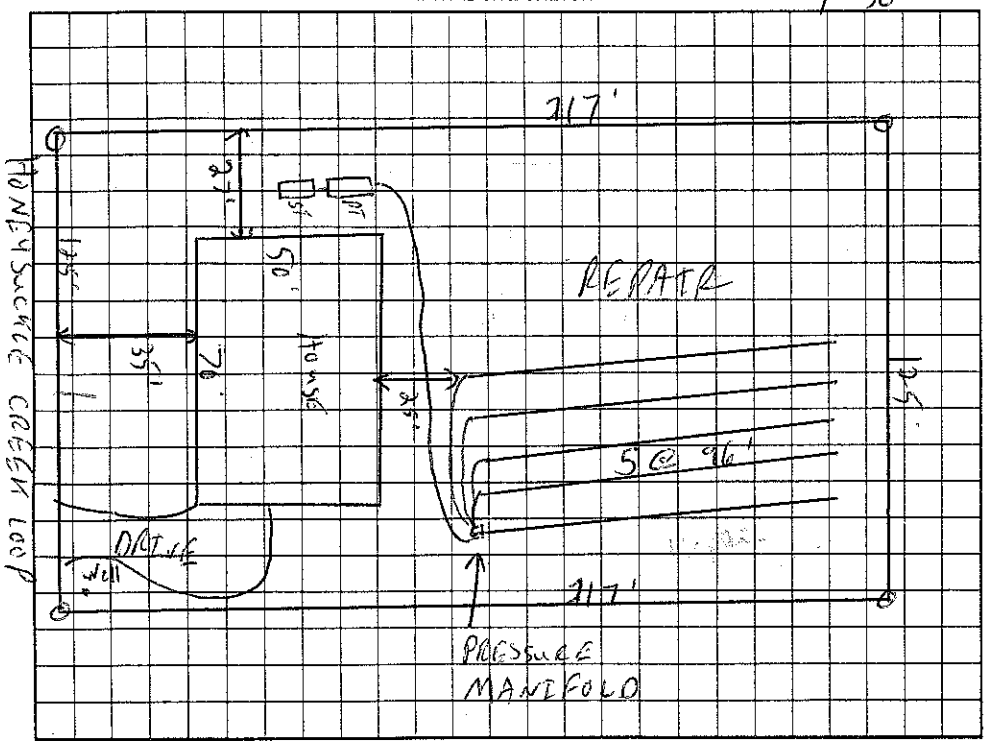

AS BUILT SKETCH

Permit can be suspended or revoked if any false information is supplied toward securing the permit/any unauthorized changes are made to the site/any unauthorized changes are made in the installation of the system. Improvement Permit with plat valid without expiration. Improvement Permit with site plan valid for sixty months. Authorization to Construct is valid for a period equal to that of Improvement Permit -- not to exceed sixty months.

Signed: date 4/2/04 Installed by: Rowan Septic Tank

Improvement Permit by: RS date 3/31/04 Operation Permit by: RS date 11/17/04

Authorization to Construct by: RS date 5/13/04 Existing System Inspection by: date

HEALTH DEPT. COPY: WHITE OWNER COPY (FINAL): YELLOW OWNER COPY (INITIAL): PINK