IREDELL COUNTY HEALTH DEPARTMENT

STATESVILLE 704-878-5305 MOORESVILLE 704-664-5281

IMPROVEMENT PERMIT / AUTHORIZATION TO CONSTRUCT / OPERATION PERMIT / EXISTING SYSTEM INSPECTION

PERMIT # 163888 PIN # 4639 97 0162 DATE 11-16-2010

OWNER or APPLICANT Mark & Amy Kuker PHONE: Business 7049285364 Home: 7045280400

OWNER or APPLICANT ADDRESS 150 Honeysuckle Lp. Troutman, NC 28166

LOCATION / DIRECTIONS Hwy 150 W TR Perth Rd TL Honeysuckle Lp (2nd) on right #150

SUBDIVISION Honeysuckle Creek BLOCK / SECTION LOT # 19 LOT AREA .62Ac. DESIGN FLOW 480 gpd L.T.A.R. .25

Exist

Septic Tank 1000 Gallons: STB Date

Pump Tank 1000 Gallons: PT Date

Pump Make Model Serial #

Nitrification Field No Fields 1 No Lines 5 Linear Feet 480

Trench Width 36" Max. Trench Bottom Depth 36" Gravel Depth N/A

☐ New System ☐ Repair ☐ Expansion System Type I II (III) IV V VI

System Description: Exist. Pump-PM-25% Reduction

Repair System Description Pump-25-50% Reduction

Maintenance Agreement Required ☐ YES ☒ NO Not initially

☐ GRAVITY ☒ PRESSURE


☒ Residence No. Bedrooms 4 ☐ Business No. Persons ☐ Other No. Employees ☐ Slab ☐ Crawl Space ☐ Basement w/plumbing ☐ Basement w/o plumbing

Water Supply ☒ Private ☐ Public ☐ Community


Comments / Conditions Existing Septic System appears to be functioning okay at time of inspection. PL 217

Comments / Conditions Existing Supply line runs under existing deck however it's located 5FT from footer (post) of deck. AOK to Screen & cover existing deck.

INITIAL SITE SKETCH

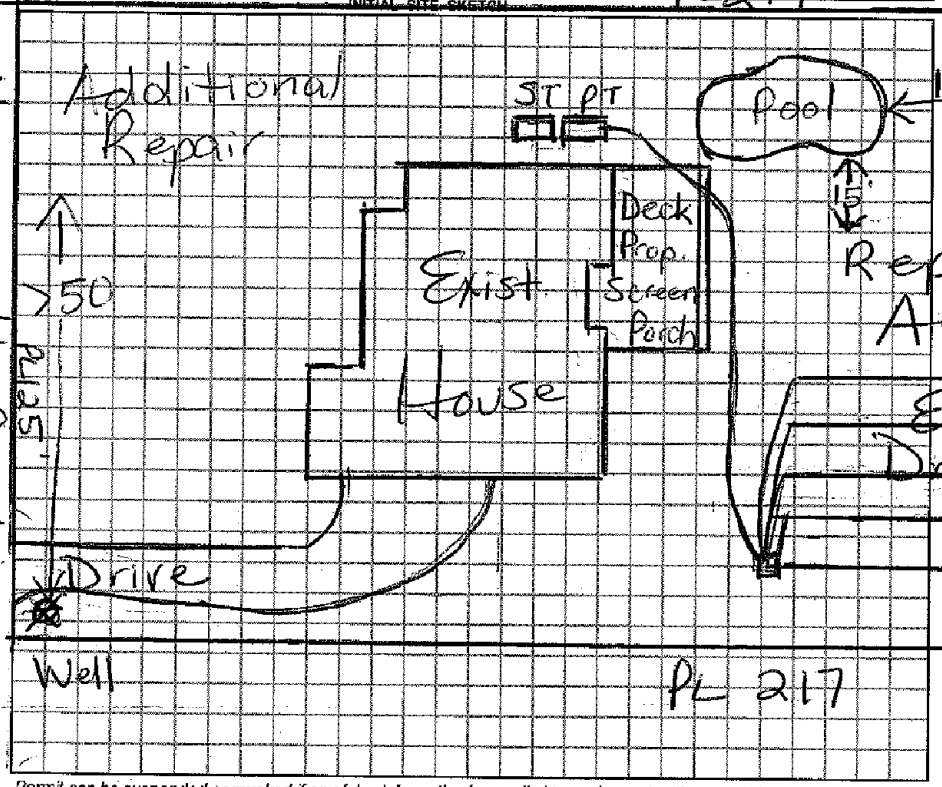

AS BUILT SKETCH

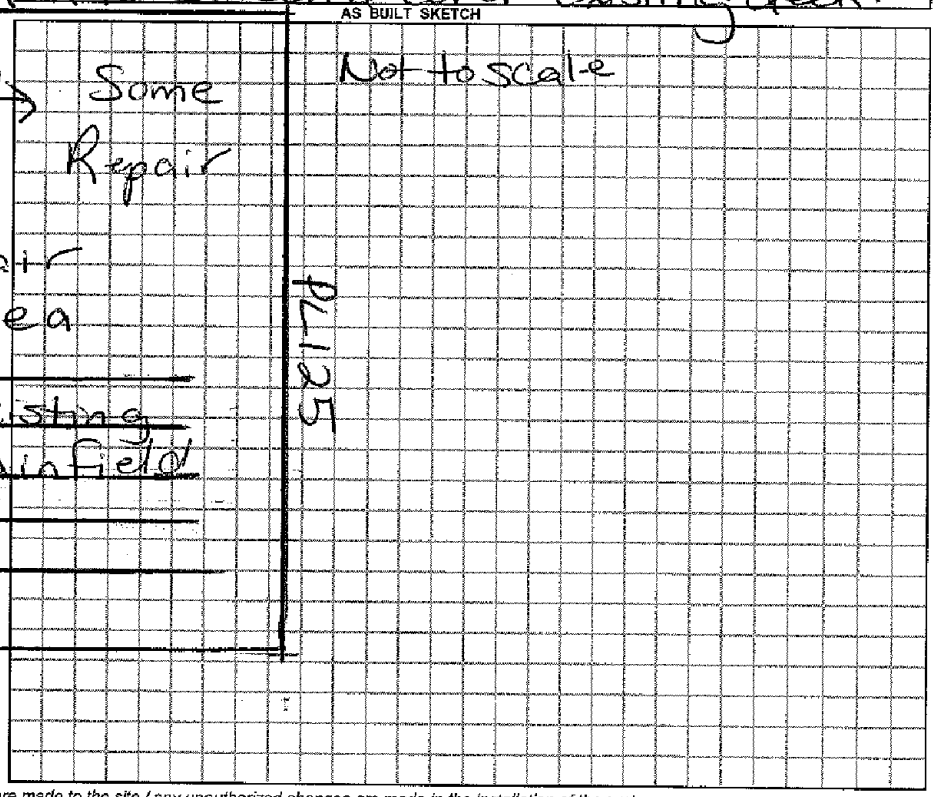

Honeysuckle Creek Lp.

Permit can be suspended or revoked if any false information is supplied toward securing the permit / any unauthorized changes are made to the site / any unauthorized changes are made in the installation of the system.

☐ *IMPROVEMENT PERMIT w / plat valid without expiration.* ☐ *IMPROVEMENT PERMIT w / site plan valid for 60 mos.* ☐ *AUTHORIZATION TO CONSTRUCT valid for period equal to IMPROVEMENT PERMIT-not to exceed 60 mo.*

Owner / Applicant Signature: Mark Kuker Date 11/16/10

Improvement Permit by: Date

Authorization to Construct by: Date

YOU SHOULD CONTACT A LOCATOR SERVICE PRIOR TO ANY EXCAVATION.

Installed by: Rowan Septic

Operation Permit by: Date:

Existing System Inspected by: Marian H. Nolan RS Date: 11/16/2010

WHITE COPY Environmental Health YELLOW COPY (Final) Owner / Applicant PINK COPY (Initial) Owner / Applicant