IREDELL COUNTY HEALTH DEPARTMENT

Statesville Office (704) 878-5305 Mooresville Office (704) 660-3625 PERMIT # 140682

IMPROVEMENT PERMIT / AUTHORIZATION TO CONSTRUCT / OPERATION PERMIT / EXISTING SYSTEM

PIN # 4639970995

APPLICANT: ADAMS HOMES APPLICANT ADDRESS: LUCY DR. HUNTERSVILLE

SITE ADDRESS: 120 NESTING QUAIL LN - Mrool. PHONE: ALT. PHONE:

SITE DIRECTIONS: PERTH (N) - TL FERN HILL - TL NESTING QUAIL - 3RD ON RT

SUBDIVISION: HIGHLAND RIDGE SECTION: - LOT # 3 LOT AREA: 1.01 AC DESIGN FLOW: 600 L.T.A.R.: .3

Septic Tank	1500 (gal)	STB	1014	Date	1-15-14	☑ New System	☐ Repair	☐ Expansion	System Type: I II (III) IV V VI	☑ Residence	No. Bedrooms 5
Pump Tank	1500 (gal)	PT	46[illegible]	Date	1-15-14	System Description:	PUMP 25% REDUCTION			☐ Business	No. Persons 10
Pump Make		Model		Serial #		Repair System Description:	LA PROPS			☐ Other	No. Employees
# Nitrification Fields	1	# Lines	5	Linear Ft:	500	Maintenance Agreement Required:	☐ YES	☑ NO		☐ Slab	☑ Crawl Space
Trench Width	36"	Max. Trench Bottom Depth	36"	Gravel Depth	N/A		☐ GRAVITY	☑ PRESSURE		☐ Basement w/plumbing	☐ Basement w/o plumbing

Water Supply: ☑ Private ☐ Public ☐ Community

Comments / Conditions:

INITIAL SITE SKETCH

SEE MICHAEL ATHANAS & ASSOCIATES PLAN.

AS BUILT SKETCH

CHECKED TANKS
LINES
SET 2' PH
5-28-14

WELLHEAD OF BA

Permit can be suspended or revoked if any false information is supplied toward securing the permit / any unauthorized changes are made to the site / any unauthorized changes are made in the installation of the system. **CONTACT A LOCATOR SERVICE PRIOR TO ANY EXCAVATION**


☐ **IMPROVEMENT PERMIT** *with plat valid without expiration.* ☐ **IMPROVEMENT PERMIT** *with site plan valid for 60 mos.* ☐ **AUTHORIZATION TO CONSTRUCT** *valid for period equal to IMPROVEMENT PERMIT--not to exceed 60 mo.*

Owner / Applicant Signature: [signature] Date: 9/24/13 Installed by: KOWAN

IMPROVEMENT PERMIT by: C. Wells Date: 9/23/13 OPERATION PERMIT by: [signature] Date: APPROVED JAN 12 2015

AUTHORIZATION TO CONSTRUCT by: C. Wells Date: 10/10/13 Existing System Inspected by: Date:

Health Dept. Copy - WHITE Applicant (Final Approval) - YELLOW Applicant (Conditional Approval) - PINK

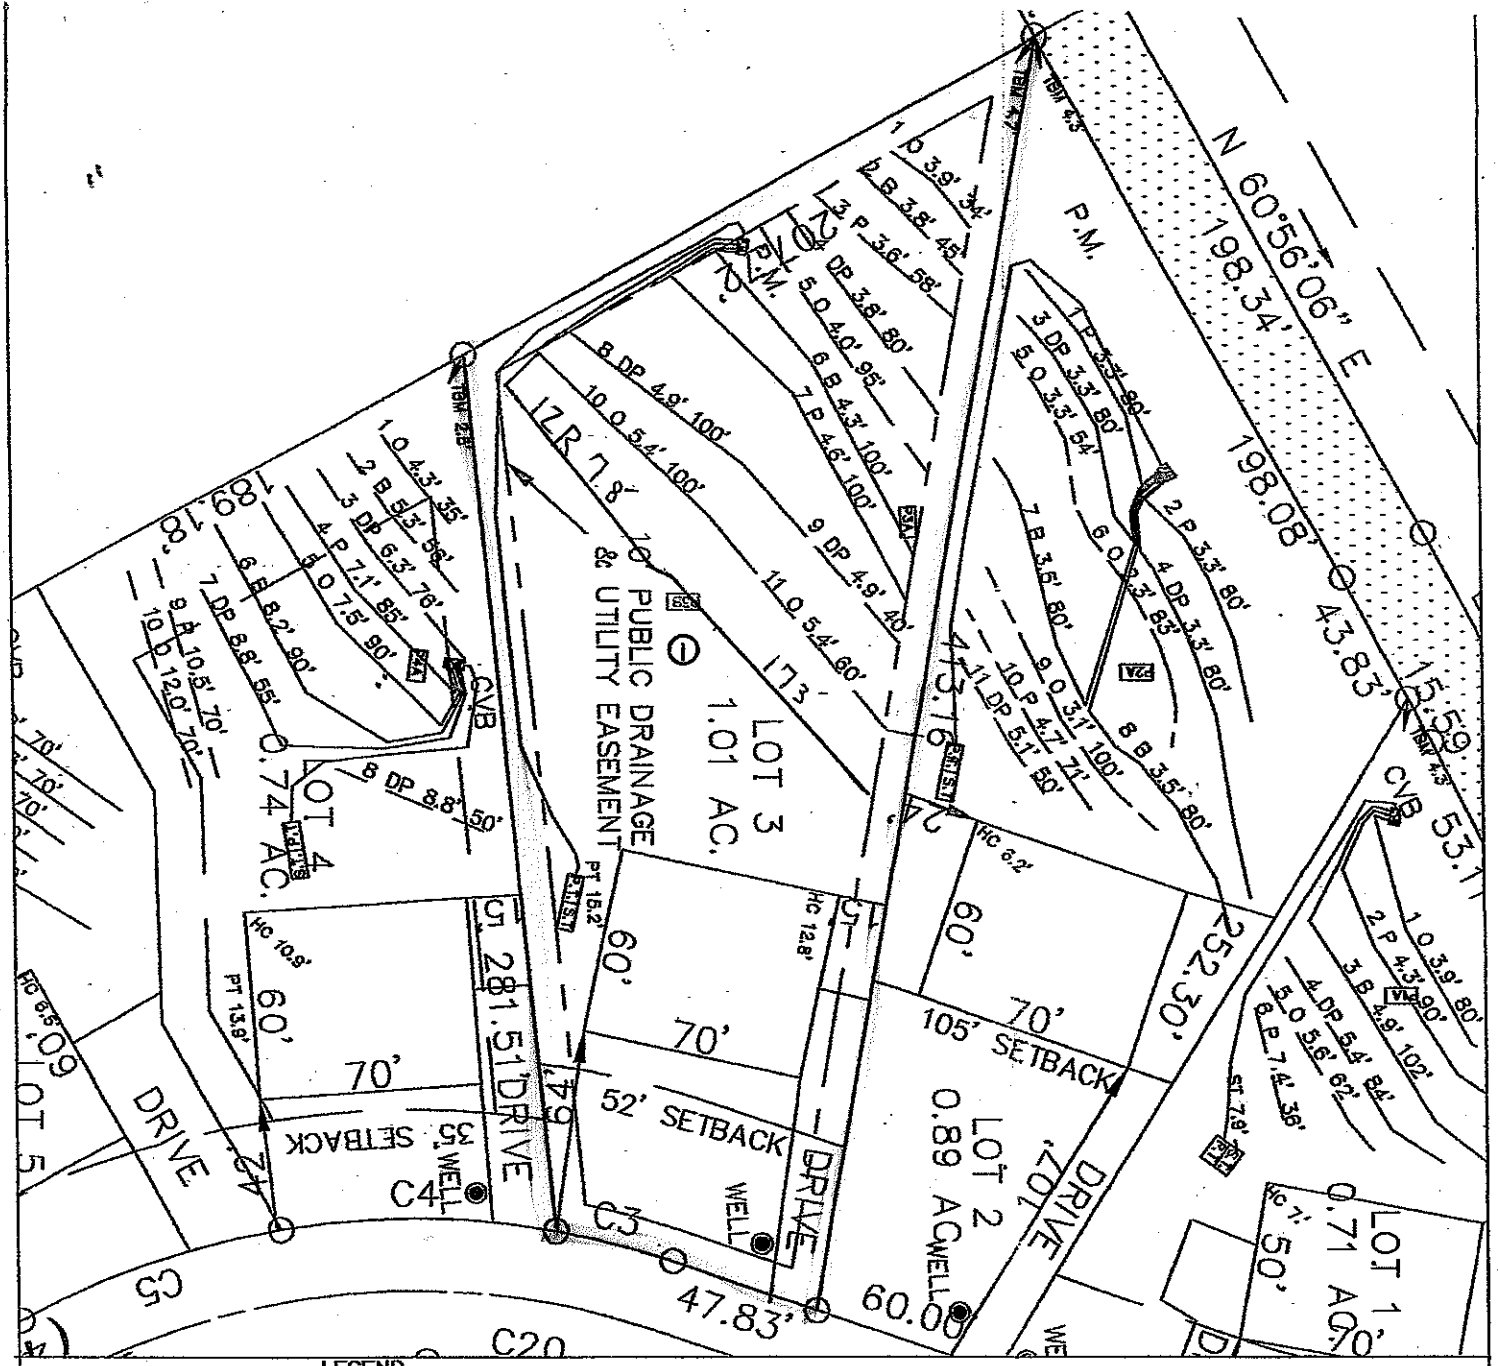

LEGEND

House Box.

System lines.

Repair lines.

House Corner Shot.

T.B.M.

GRAPHIC SCALE
1" = 60'

60 0 60 120

FOR PRELIMINARY PLANNING PURPOSES ONLY. ALL LOTS WILL REQUIRE FINAL APPROVAL BY THE COUNTY HEALTH DEPARTMENT ON A LOT BY LOT BASIS. THIS MAP SHOULD BY USED AS A GENERAL GUIDE, SOME ADJUSTMENTS WILL BE NECESSARY IN THE FIELD DUE TO SOIL VARIABILITY AND COMPLEX TOPOGRAPHIC FEATURES. THIS MAP ONLY REFLECTS EXISTING SOIL SUITABILITY FOR ON-SITE SEPTIC TANK SYSTEMS.

PLEASE REFER TO ATTACHED SOIL REPORT FOR ADDITIONAL SITE SPECIFIC INFORMATION

ROLLANS SOIL & ENVIRONMENTAL SERVICES
2128 GRAHAM ROAD
MOUNT ULLA, NC 28125
PHONE/FAX: (704)278-0989
ASHLEY ROLLANS, NC LICENSED SOIL SCIENTIST
MOBILE: (704)746-5016
EMAIL: ROLLANSFORTC@AOL.COM

MAP TITLE: SITE PLAN & DRAINFIELD AREAS

PROJECT NAME: GROVES OF ELC / HIGHLAND RIDGE

LOCATION/DATE: PEGRAM ROAD, IREDELL COUNTY, NORTH CAROLINA FEBRUARY 2007

JOB # : 01-1329
FILE: C:\JOBS\01-1329
PROJECT MGR.: C.B.F.
FIELD WORK: C.B.F. & A.L.P.
DRAWN BY: C.B.F.