IREDELL COUNTY HEALTH DEPARTMENT

STATESVILLE 704-878-5305 MOORESVILLE 704-664-5281

IMPROVEMENT PERMIT / AUTHORIZATION TO CONSTRUCT / OPERATION PERMIT / EXISTING SYSTEM INSPECTION

PERMIT# 116728 PIN# ~~4639-96-2969-17~~ 4639-97-3135 DATE 7/27/04

OWNER OR CONTRACTOR Lewis Carpenter PHONE: Business 704-545-4652 Home

ADDRESS PO Box 690027 Charlotte, NC. 28227

LOCATION Honeysuckle Creek Lp; Perth, N TL 2ND Honeysuckle Creek lot on (R) at crest of hill

SUBDIVISION Honeysuckle Creek BLOCK / SECTION LOT 17 LOT AREA .62 AC SITE CLASS. PS DESIGN FLOW 480 L.T.A.R. .3

Septic Tank: 1000 Gallons; STB 794 Date 3/29/04
Pump Tank: Gallons; PT Date
Pump Make: Model Serial No.
Nitrification Field: No Fields 1 Square Feet 1200 Linear Feet 400
No Lines 4 @ 100' Trench Width 3' Max Trench Bottom Depth 3' Gravel Depth No


[X] New System [ ] Repair System Type: I, II, (III), IV, V, VI
System Description: Gravity - 25% Reduction
Repair System Description: Same Type
Maintenance Agreement Required: [ ] Yes [X] No

[X] House/Mod. Home No. Bedrooms 4
[ ] Mobile Home No. Bathrooms 3
[ ] Business No. Employees
[ ] Other
[ ] Slab [ ] Crawl Space [ ] Basement w/plumbing [ ] Basement wo/plumbing

Water Supply: [X] Individual [ ] Public [ ] Community


Comments:/Conditions: House site not graded down, Gravity is feasible provided the Plumbing Stub-Out is kept flush with ground surface.

INITIAL SITE SKETCH

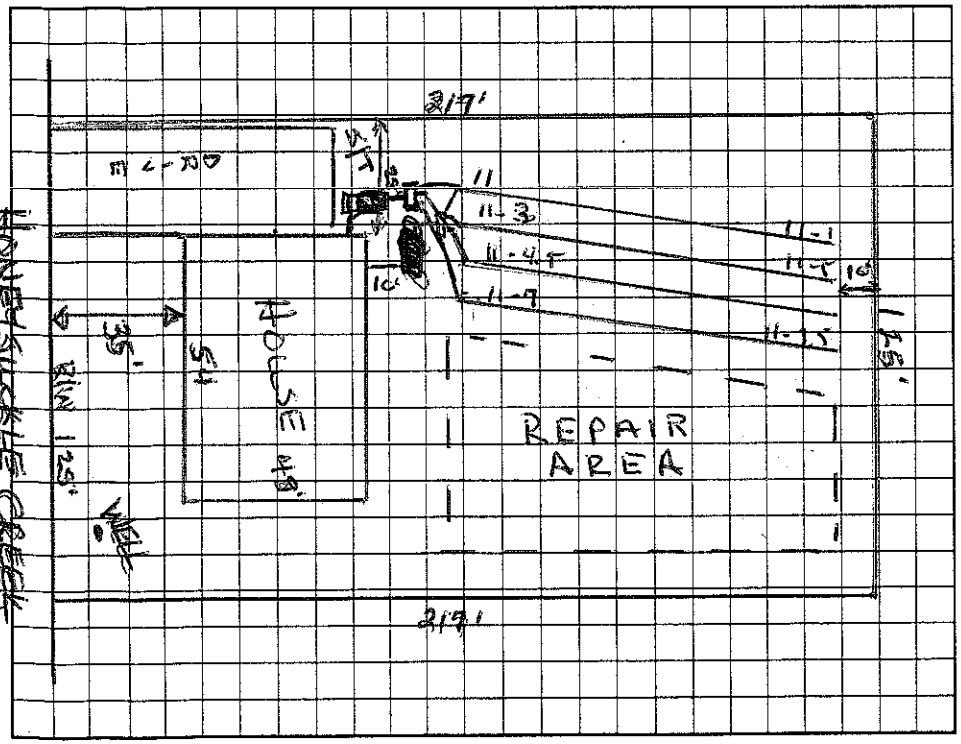

Comments:/Conditions:

AS BUILT SKETCH

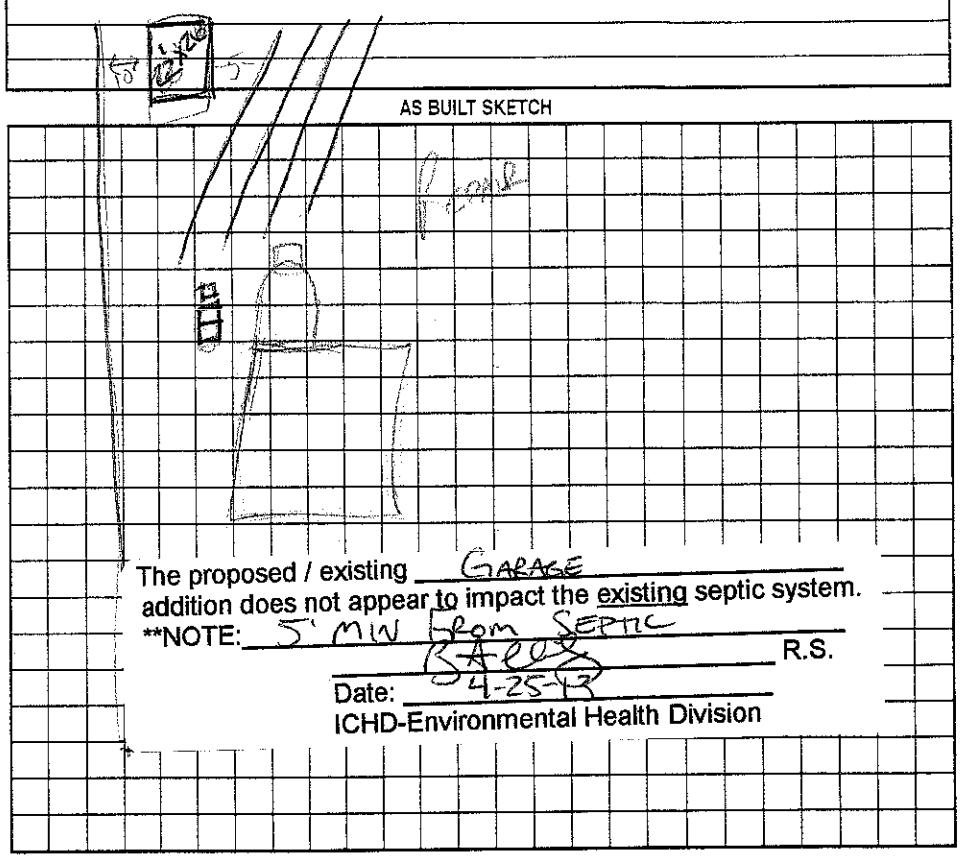

The proposed / existing GARAGE addition does not appear to impact the existing septic system.
**NOTE: 5' MW from SEPTIC
R.S.
Date: 4-25-13
ICHD-Environmental Health Division

Permit can be suspended or revoked if any false information is supplied toward securing the permit/any unauthorized changes are made to the site/any unauthorized changes are made in the installation of the system. Improvement Permit with plat valid without expiration. Improvement Permit with site plan valid for sixty months. Authorization to Construct is valid for a period equal to that of Improvement Permit – not to exceed sixty months.

Signed: Lewis Carpenter date 8/11/04
Improvement Permit by: Wesley Sparks R.S. date 7/27/04
Authorization to Construct by: Wesley Sparks R.S. date 7/27/04
Installed by: Larry Beam
Operation Permit by: Wesley Sparks R.S. date 10/5/04
Existing System Inspection by: date

HEALTH DEPT. COPY: WHITE OWNER COPY (FINAL): YELLOW OWNER COPY (INITIAL): PINK

IREDELL COUNTY HEALTH DEPARTMENT

STATESVILLE 704-878-5305 MOORESVILLE 704-664-5281

AD #50

IMPROVEMENT PERMIT / AUTHORIZATION TO CONSTRUCT / OPERATION PERMIT / EXISTING SYSTEM INSPECTION

PERMIT# 116728 PIN# 4639462769.17 DATE 3/31/04

OWNER OR CONTRACTOR HONEYSUCKLE CREEK LLC/LEWIS CARPENTER PHONE: Business 701-6465 Home

ADDRESS 227 HIDEAWAY L N MOORESVILLE NC 28117

LOCATION PERTH (N) - TL 2nd HONEYSUCKLE CREEK Loop - ON RT

SUBDIVISION HONEYSUCKLE CREEK BLOCK / SECTION LOT 17 LOT AREA 1.62AC SITE CLASS. PS DESIGN FLOW 450GPD L.T.A.R. .36GPD/FT2

Septic Tank: 1000 Gallons; STB Date

Pump Tank: 1000 Gallons; PT Date

Pump Make: Model Serial No.

Nitrification Field: No Fields 1 Square Feet 1200 Linear Feet 400

No Lines 4@100' Trench Width 36" Max Trench Bottom Depth 36" Gravel Depth

☑ New System ☐ Repair System Type: I, II, III, IV, V, VI

System Description: PUMP 25% REDUCTION

Repair System Description: LT PANEL

Maintenance Agreement Required: ☑ Yes ☐ No

☑ House/Mod. Home No. Bedrooms 4

☐ Mobile Home No. Bathrooms 4

☐ Business No. Employees

☐ Other


☐ Slab ☑ Crawl Space ☐ Basement w/plumbing ☐ Basement wo/plumbing

Water Supply: ☑ Individual ☐ Public ☐ Community


Comments:/Conditions: DO NOT CUT HOUSE PAD

Comments:/Conditions:

INITIAL SITE SKETCH 1" = 50'

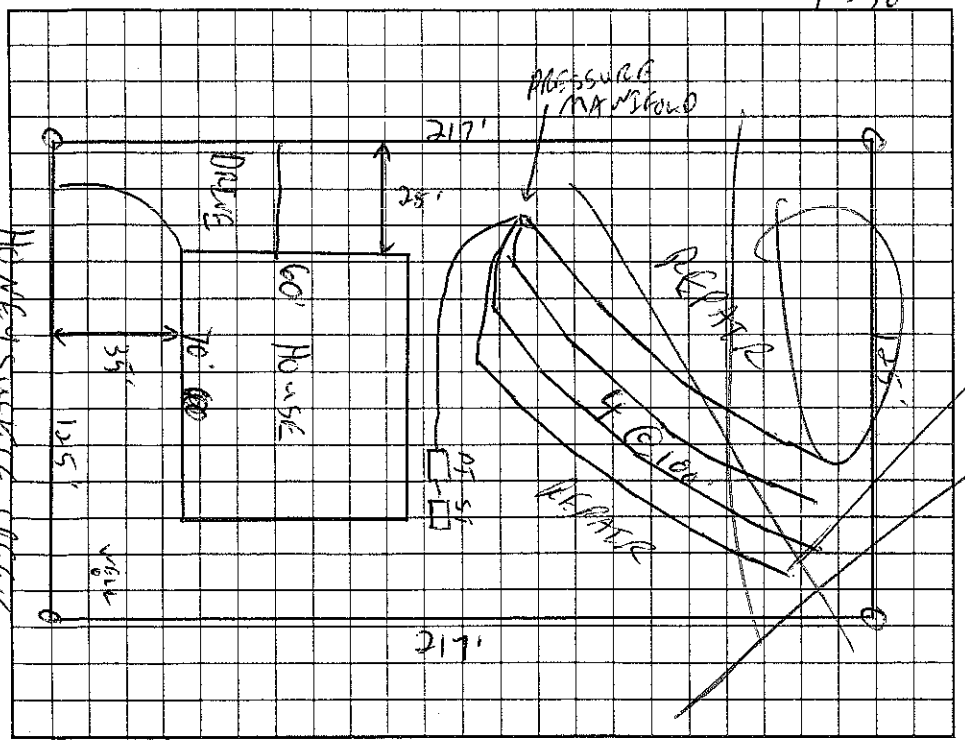

AS BUILT SKETCH

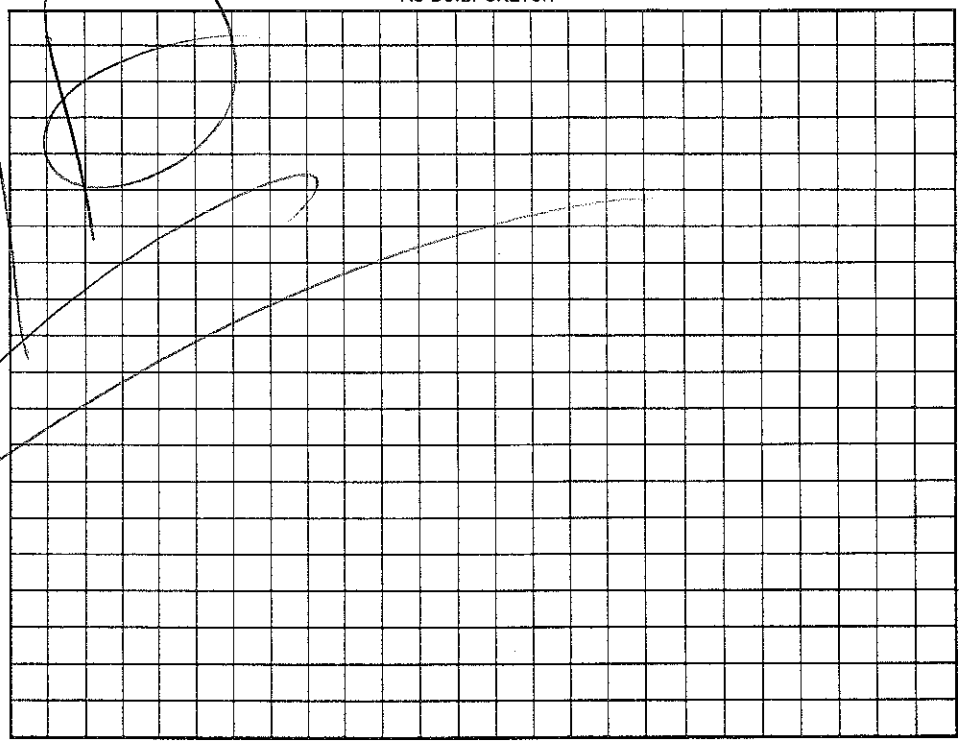

Permit can be suspended or revoked if any false information is supplied toward securing the permit/any unauthorized changes are made to the site/any unauthorized changes are made in the installation of the system. Improvement Permit with plat valid without expiration. Improvement Permit with site plan valid for sixty months. Authorization to Construct is valid for a period equal to that of Improvement Permit – not to exceed sixty months.

Signed: date 4-2-04 Installed by:

Improvement Permit by: RS date 3/31/04 Operation Permit by: date

Authorization to Construct by: Wesley Sparks RS. date 6/3/04 Existing System Inspection by: date

HEALTH DEPT. COPY: WHITE OWNER COPY (FINAL): YELLOW OWNER COPY (INITIAL): PINK