IREDELL COUNTY HEALTH DEPARTMENT

STATESVILLE 704-878-5205 MOORESVILLE 704-664-5281

IMPROVEMENT PERMIT / AUTHORIZATION TO CONSTRUCT / OPERATION PERMIT / EXISTING SYSTEM INSPECTION

PERMIT# 116727 PIN# 4639962769.16 DATE 3/31/04

OWNER OR CONTRACTOR HONEYSUCKLE CREEK LLC/LEWIS CARPENTER PHONE: Business 201-6465 Home

ADDRESS 227 HIDEAWAY LN MOORESVILLE NC 28117

LOCATION PERTH (N) - TL 2nd HONEYSUCKLE CREEK LP. - O.N RT

SUBDIVISION HONEYSUCKLE CREEK BLOCK / SECTION LOT 16 LOT AREA 1.62AC. SITE CLASS. PS DESIGN FLOW 480GPD L.T.A.R. 1256 SQ FT

Septic Tank: 1000 Gallons: STB 794 Date 2/23/05
Pump Tank: Gallons: PT Date
Pump Make: Model Serial No.
Nitrification Field: No Fields 1 Square Feet 1440 Linear Feet 480
No Lines 5@96' Trench Width 36" Max Trench Bottom Depth 36" Gravel Depth N/A

☒ New System ☐ Repair System Type: I, II, III, IV, V, VI
System Description: GRAVITY 25% REDUCTION
Repair System Description: LP PANEL
Maintenance Agreement Required: ☐ Yes ☒ No 320' REQ


☒ House/Mod. Home No. Bedrooms 4
☐ Mobile Home No. Bathrooms 4
☐ Business No. Employees
☐ Other
☐ Slab ☒ Crawl Space ☐ Basement w/plumbing ☐ Basement wo/plumbing

Water Supply: ☒ Individual ☐ Public ☐ Community


Comments:/Conditions: DO NOT CUT HOUSE PAD - [illegible]

Comments:/Conditions:

INITIAL SITE SKETCH 1" = 50'

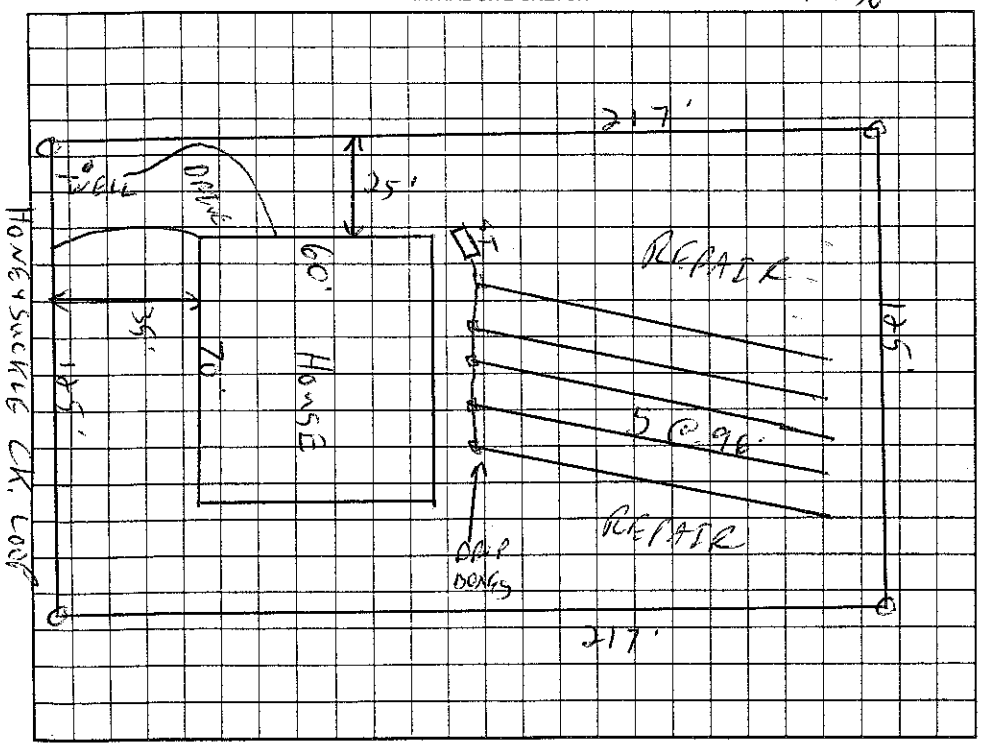

AS BUILT SKETCH

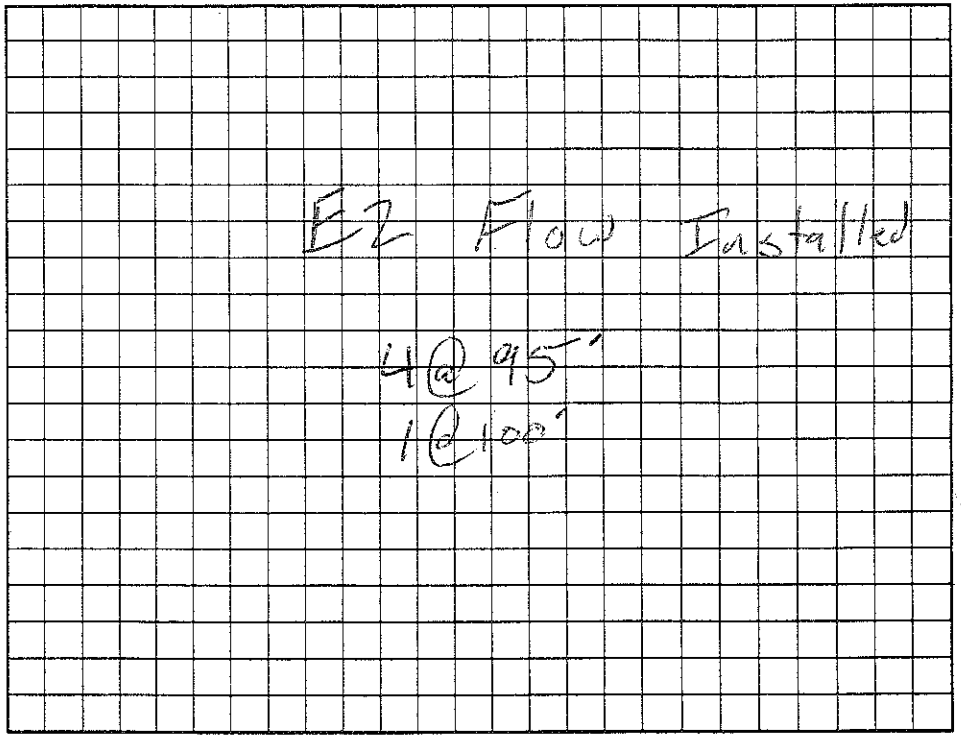

Permit can be suspended or revoked if any false information is supplied toward securing the permit/any unauthorized changes are made to the site/any unauthorized changes are made in the installation of the system. Improvement Permit with plat valid without expiration. Improvement Permit with site plan valid for sixty months. Authorization to Construct is valid for a period equal to that of Improvement Permit – not to exceed sixty months.

Signed: [signature] date 4-2-04

Improvement Permit by: [signature] RS date 3/31/04

Authorization to Construct by: [signature] RS date 6-3-04

Installed by: Larry Beam

Operation Permit by: [signature] RS date 4/6/05

Existing System Inspection by: date

HEALTH DEPT. COPY: WHITE OWNER COPY (FINAL): YELLOW OWNER COPY (INITIAL): PINK