2730

IREDELL COUNTY HEALTH DEPARTMENT

STATESVILLE 704-878-5305 MOORESVILLE 704-664-5281

IMPROVEMENT PERMIT / AUTHORIZATION TO CONSTRUCT / OPERATION PERMIT / EXISTING SYSTEM INSPECTION

PERMIT# ~~440739~~ 18203 PIN# 4639-97-4800 DATE May 18, 2007

OWNER OR APPLICANT Orchard Farms LLC PHONE: Business Home

ADDRESS 227 Hillcrest Cir, Mooresville, N.C. 28117

LOCATION Forth Rd (W) to Fern Hill Tr. Nesting Quail on left past jct w/ Tall Fescue

SUBDIVISION Highland Ridge BLOCK / SECTION LOT 22 LOT AREA 1.16 Ac SITE CLASS: 1S DESIGN FLOW 440 gpd L.T.A.R. .275

Septic Tank: 1000 Gallons: STB 825 Date 2-20-14

Pump Tank: 1000 Gallons: PT 302 Date 1-15-14

Pump Make: Zoeller Model N152 Serial No.

Nitrification Field: No Fields 1 Square Feet 900 # Linear Feet 300

No Lines 3@100' Trench Width 36" # Max Trench Bottom Depth 36" Gravel Depth

☒ New System ☐ Repair ☐ Expansion System Type: I II III ⓘ V VI

System Description: LPPPBPS

Repair System Description: LPPPBPS

Maintenance Agreement Required: ☒ Yes ☐ No

☒ House/Mod. Home ☐ Mobile Home ☐ Business ☐ Other

No. Bedrooms 4 No. Persons No. Employees


Water Supply: ☒ Individual ☐ Public ☐ Community

☐ Gravity ☒ Pressure ☒ Slab ☒ Crawl Space ☐ Basement w/plumbing ☐ Basement wo/plumbing


Comments:/Conditions: Slab foundation to be built up for positive drainage, do not cut

Comments:/Conditions: 2 upper ALP lines checked & tanks 5/32" hole drilled 5/14/14

INITIAL SITE SKETCH

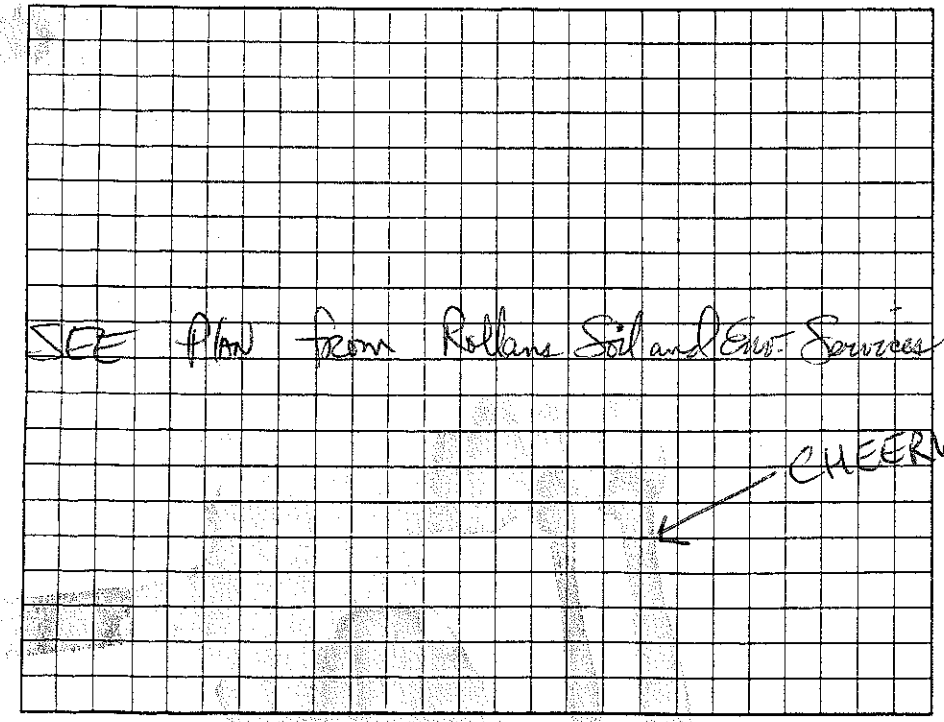

AS BUILT SKETCH

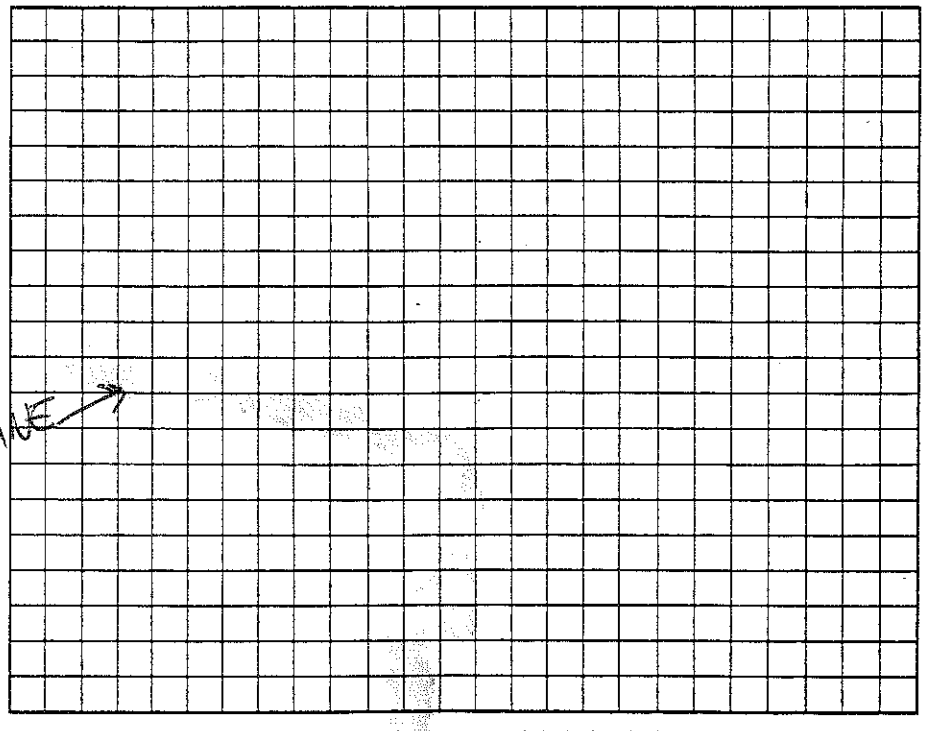

Permit can be suspended or revoked if any false information is supplied toward securing the permit/any unauthorized changes are made to the site/any unauthorized changes are made in the installation of the system. Improvement Permit with plat valid without expiration ☐ Improvement Permit with site plan valid for sixty months ☒ Authorization to Construct is valid for a period equal to that of Improvement Permit – not to exceed sixty months.

Signed date 6-7-07 Installed by: Kowan Septic

Improvement Permit by: date 5-18-07 Operation Permit by: date 5/21/14

Authorization to Construct by: date 10-14-13 Existing System Inspection by: date

HEALTH DEPT. COPY: WHITE OWNER COPY (FINAL): YELLOW OWNER COPY (INITIAL): PINK