IREDELL COUNTY HEALTH DEPARTMENT

Statesville Office (704) 878-5305 Mooresville Office (704) 660-3625 A2P PERMIT # 204302

IMPROVEMENT PERMIT / AUTHORIZATION TO CONSTRUCT / OPERATION PERMIT / EXISTING SYSTEM

PIN # 4639974862 5835

APPLICANT: Adams Homes APPLICANT ADDRESS: 3000 Gulf Breeze Pkwy Gulf Breeze Fla 32563

SITE ADDRESS: 116 Tall Fern Loop PHONE: (904) 576 3387 ALT. PHONE:

SITE DIRECTIONS: Go 150 W TR on Perth Rd TL on Fern Hill TL on Nesting Quail TL on Tall Fern 1st on right

SUBDIVISION: Highland Ridge SECTION: - LOT # 26 LOT AREA: .59 ac DESIGN FLOW: 480 L.T.A.R.: .3E/.25R

Septic Tank	1000 (gal)	STB	825	Date	11/10/14	☑ New System ☐ Repair ☐ Expansion	System Type: I II III (IV) V VI	☑ Residence	No. Bedrooms 4
Pump Tank	1000 (gal)	PT	302	Date	8/20/14	System Description: 1PP gravel block		☐ Business	No. Persons 8
Pump Make		Model		Serial #		Repair System Description: 1PP gravel block		☐ Other	No. Employees
# Nitrification Fields	1	# Lines	4	Linear Ft:	270'	Maintenance Agreement Required: ☑ YES ☐ NO		☐ Slab	☑ Crawl Space
Trench Width	24"	Max. Trench Bottom Depth	36"	Gravel Depth	N/A	☐ GRAVITY ☑ PRESSURE		☐ Basement w/plumbing	☐ Basement w/o plumbing

Water Supply: ☑ Private ☐ Public ☐ Community

Comments / Conditions: well on lot 21 was abandoned w/ driller's log attached on condition for A/C.

7/23/15 Electro alarm ok, need Maint. Contract

INITIAL SITE SKETCH

See approved plans from Mike Athanas and associates Dated 12/8/14

AS BUILT SKETCH

* waiting for electrical alarm/pump connection insp and certified operator contract

drain lines, tanks, drop boxes and pressure heads set and approved on 1/6/14 Richard Farris

Permit can be suspended or revoked if any false information is supplied toward securing the permit / any unauthorized changes are made to the site / any unauthorized changes are made in the installation of the system. **CONTACT A LOCATOR SERVICE PRIOR TO ANY EXCAVATION**


☐ **IMPROVEMENT PERMIT** *with plat valid without expiration.* ☑ **IMPROVEMENT PERMIT** *with site plan valid for 60 mos.* ☑ **AUTHORIZATION TO CONSTRUCT** *valid for period equal to IMPROVEMENT PERMIT--not to exceed 60 mo.*

Owner / Applicant Signature: Date: 12/17/14 Installed by: Rogers Septic

IMPROVEMENT PERMIT by: Richard Farris Date: 12/8/14 OPERATION PERMIT by: Maria Dotson RS Date: 8/17/15

AUTHORIZATION TO CONSTRUCT by: Richard Farris Date: 12/8/14 Existing System Inspected by: Date:

Health Dept. Copy - WHITE Applicant (Final Approval) - YELLOW Applicant (Conditional Approval) - PINK

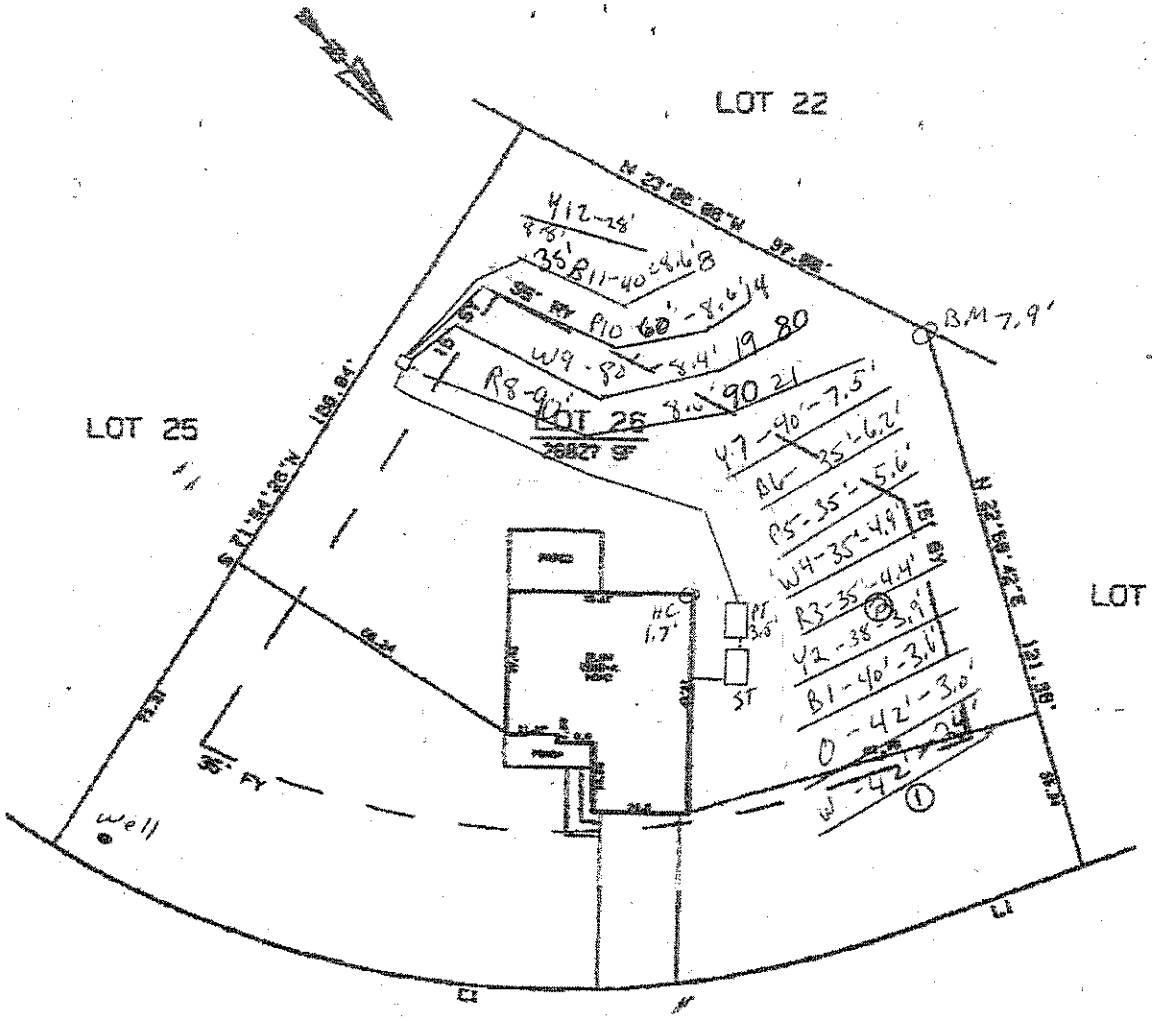

TALL FERN LOOP

45' PUBLIC R/W

APPROVED DEC 08 2014

Richard Farris

LINE	BEARING	DISTANCE
L 1	S 71°55'54"E	48.14'

CURVE	DELTA ANGLE	RADIUS	ARC	TANGENT	CHORD	CHORD BEARING
C 1	52°32'35"	287.58'	196.29'	102.42'	189.69'	S 44°51'48"E

ADAMS HOMES

PLOT PLAN

OF

116 TALL FERN LOOP
LOT 26 OF HIGHLAND RIDGE
FALLSTOWN TOWNSHIP, IREDELL COUNTY, N.C.

SCALE - 1" = 40'

0 20 40 60 80

MAP RECORDED IN BOOK 53
AT PAGE 28

ADDED#12
DATE: 05/03/14
DSK AD#27 HLR26
DRAWN BY ASH/CLJ