IREDELL COUNTY HEALTH DEPARTMENT

STATESVILLE 704-878-5305 MOORESVILLE 704-664-5281

IMPROVEMENT PERMIT / AUTHORIZATION TO CONSTRUCT / OPERATION PERMIT / EXISTING SYSTEM INSPECTION

PERMIT# 11672.4 PIN# ~~4639-96-2769.14~~ 4639-97-7119 DATE 3/31/04

OWNER OR CONTRACTOR HONEYSUCKLE CREEK, LLC / PRIDE HOMES PHONE: Business 201-6465 Home

ADDRESS 227 HIDEAWAY LN, MOORESVILLE, NC 28117

LOCATION PERTH (N) - TL 2nd HONEYSUCKLE CREEK - ON RT

SUBDIVISION ~~HONEYSUCKLE CREEK~~ BLOCK / SECTION LOT 14 LOT AREA .62 AC SITE CLASS. PS DESIGN FLOW 450GPD L.T.A.R. .250GPD/FT²

Septic Tank: 1000 Gallons; STB 1017 Date 4/24/05

Pump Tank: 1000 Gallons; PT 17 Date 4/8/05

Pump Make: Model Serial No.

Nitrification Field: No Fields 1 Square Feet 700 Linear Feet 350

No Lines 4 Trench Width 24" Max Trench Bottom Depth 36" Gravel Depth N/A

☑ New System ☐ Repair System Type: I, II, III, (IV), V, VI

System Description: LP PANEL

Repair System Description: SAME

Maintenance Agreement Required: ☑ Yes ☐ No

☑ House/Mod. Home No. Bedrooms 4

☐ Mobile Home No. Bathrooms 4

☐ Business No. Employees

☐ Other


☐ Slab ☑ Crawl Space ☐ Basement w/plumbing ☐ Basement wo/plumbing

Water Supply: ☑ ~~Individual~~ ☐ Public ☐ Community

Comments:/Conditions: DO NOT CUT HOUSE PAD

Comments:/Conditions:

INITIAL SITE SKETCH 1"=50'

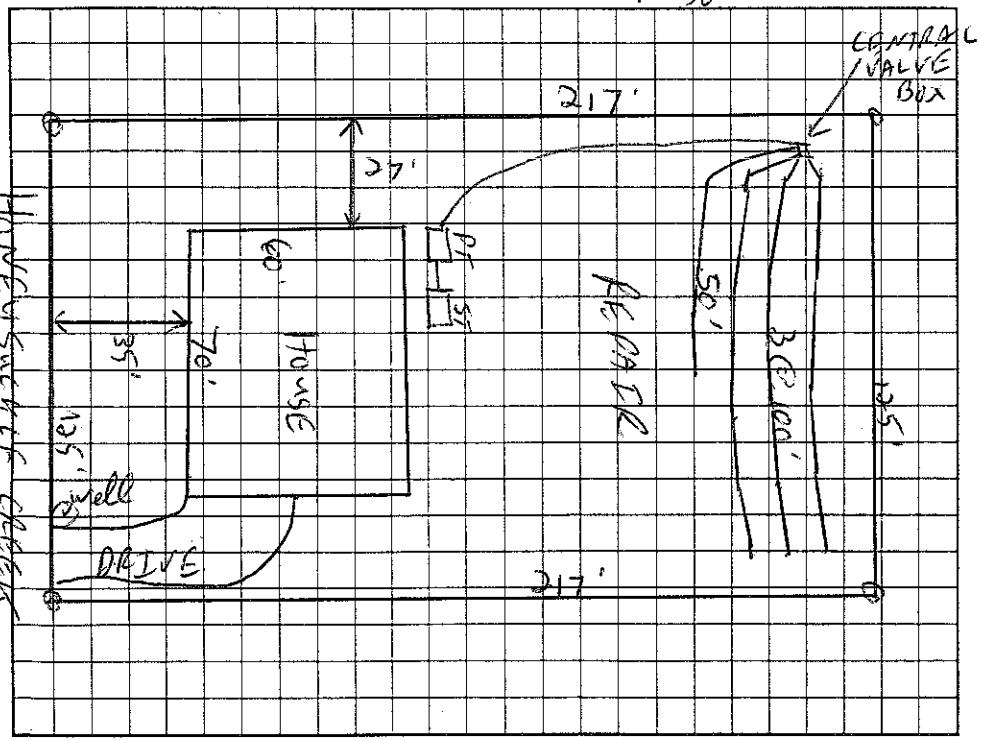

AS BUILT SKETCH

Permit can be suspended or revoked if any false information is supplied toward securing the permit/any unauthorized changes are made to the site/any unauthorized changes are made in the installation of the system. Improvement Permit with plat valid without expiration. Improvement Permit with site plan valid for sixty months. Authorization to Construct is valid for a period equal to that of Improvement Permit – not to exceed sixty months.

Signed: date 4-2-04 Installed by: C+S

Improvement Permit by: RS date 3/31/04 Operation Permit by: RS date 1/27/06

Authorization to Construct by: RS. date 7/18/05 Existing System Inspection by: date

HEALTH DEPT. COPY: WHITE OWNER COPY (FINAL): YELLOW OWNER COPY (INITIAL): PINK