IREDELL COUNTY HEALTH DEPARTMENT

STATESVILLE 704-878-5305 MOORESVILLE 704-664-5281

IMPROVEMENT PERMIT / AUTHORIZATION TO CONSTRUCT / OPERATION PERMIT / EXISTING SYSTEM INSPECTION

PERMIT# 116724 PIN# 4639.96 2769.14 DATE 3/31/04

OWNER OR CONTRACTOR HONEYSUCKLE CREEK, LLC / PRIDE HOMES PHONE: Business 201-6765 Home

ADDRESS 227 HEDGEWAY LN MOORESVILLE, NC 28117

LOCATION NORTH (N) - TL 2nd HONEYSUCKLE CREEK - O.N RT

SUBDIVISION HONEYSUCKLE CREEK BLOCK / SECTION LOT 14 LOT AREA .62 AC SITE CLASS. CS DESIGN FLOW 480GPD L.T.A.R. .25 GPD/EFA

Septic Tank: 1000 Gallons: STB 1217 Date 4/20/05

Pump Tank: 1000 Gallons: PT 17 Date 4/5/05

Pump Make: Model Serial No.

Nitrification Field: No Fields 1 Square Feet 700 Linear Feet 350

No Lines 4 Trench Width 24" Max Trench Bottom Depth 36" Gravel Depth NA

☑ New System ☐ Repair System Type: I, II, III, IV, V

System Description: LC CANAL

Repair System Description: SAME

Maintenance Agreement Required: ☑ Yes ☐ No

☑ House/Mod. Home ☐ Mobile Home ☐ Business ☐ Other

No. Bedrooms 4 No. Bathrooms 4 No. Employees


Water Supply: ☐ Individual ☐ Public ☐ Community

☐ Slab ☑ Crawl Space ☐ Basement w/plumbing ☐ Basement w/o plumbing


Comments/Conditions: DO NOT CUT HOUSE PAD

Comments/Conditions:

INITIAL SITE SKETCH 1"=50'

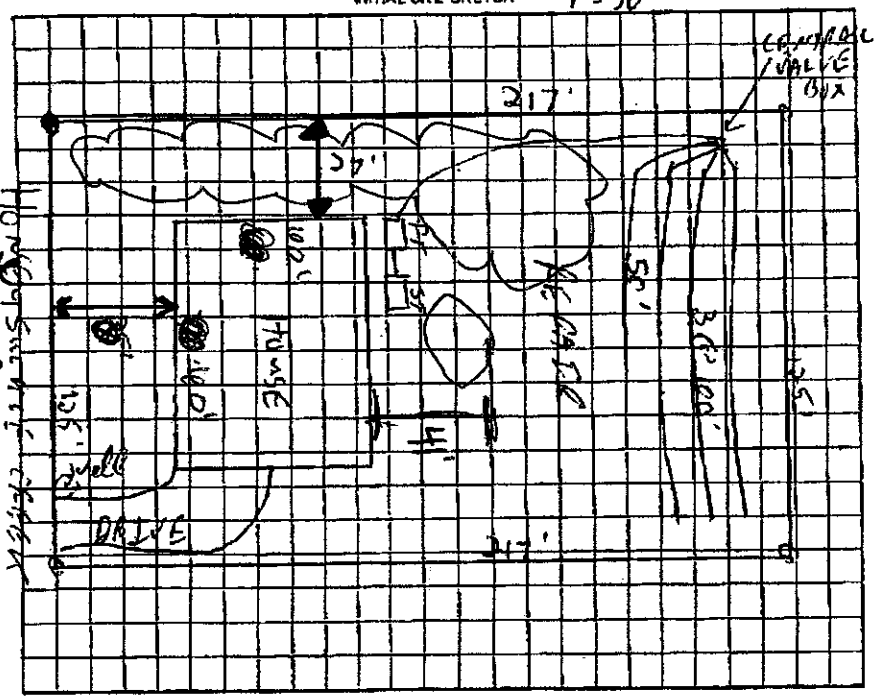

AS BUILT SKETCH

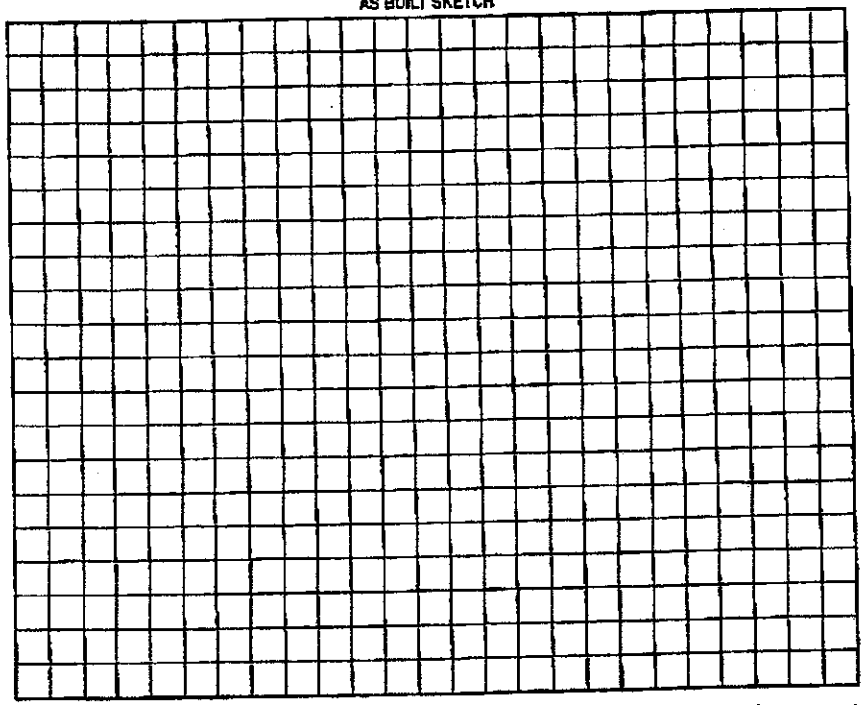

Permit can be suspended or revoked if any false information is supplied toward securing the permit/any unauthorized changes are made to the site/any unauthorized changes are made in the installation of the system. Improvement Permit with plat valid without expiration. Improvement Permit with site plan valid for sixty months. Authorization to Construct is valid for a period equal to that of Improvement Permit – not to exceed sixty months.

Signed: _____ date 4-2-04 Installed by: C&S

Improvement Permit by: _____ RS date 3/31/04 Operation Permit by: _____ RS date 4/27/05

Authorization to Construct by: _____ RS. date 7/18/05 Existing System Inspection by: _____ date _____

HEALTH DEPT. COPY: WHITE OWNER COPY (FINAL): YELLOW OWNER COPY (INITIAL): PINK

41'

118 Honeysuckle

Remax Executive Fax 704 749-2368

PAGE 02/02

08/26/2008 00:54 704-6649737