IREDELL COUNTY HEALTH DEPARTMENT

STATESVILLE 704-878-5305 MOORESVILLE 704-664-5281

IMPROVEMENT PERMIT / AUTHORIZATION TO CONSTRUCT / OPERATION PERMIT / EXISTING SYSTEM INSPECTION

PERMIT# 116708 PIN# ~~4639496276413~~ 4639-97-8240 DATE 3/31/04

OWNER OR CONTRACTOR HONEYSUCKLE CREEK LLC. / A-Side Homes PHONE: Business 201-6465 Home

ADDRESS 227 HIDEAWAY LN MOORESVILLE NC 28117

LOCATION PERTH (N) - TL 280 HONEYSUCKLE LOOP - 2nd ON RT

SUBDIVISION HONEYSUCKLE CREEK BLOCK / SECTION LOT 13 LOT AREA 1.574c SITE CLASS. PS DESIGN FLOW 480GPD L.T.A.R. .256GPD/FT²

Septic Tank: 1000 Gallons; STB 1817 Date 4/25/05

Pump Tank: 1000 Gallons; PT PT Date 8/7/05

Pump Make: Model Serial No.

Nitrification Field: No Fields 1 Square Feet 640 Linear Feet 320

No Lines 4@80' Trench Width 24" Max Trench Bottom Depth 36" Gravel Depth

☑ New System ☐ Repair System Type: I, II, III, IV, V, VI

System Description: LP PANEL

Repair System Description: SAME

Maintenance Agreement Required: ☑ Yes ☐ No

☑ House/Mod. Home No. Bedrooms 4

☐ Mobile Home No. Bathrooms 4

☐ Business No. Employees

☐ Other


☐ Slab ☑ Crawl Space ☐ Basement w/plumbing ☐ Basement wo/plumbing

Water Supply: ☑ Individual ☐ Public ☐ Community

Comments:/Conditions: DO NOT CUT HOUSE PAD. SMOOTH AREA IN BACK WHERE OLD ROAD BED IS.

Comments:/Conditions:

INITIAL SITE SKETCH 1"=50'

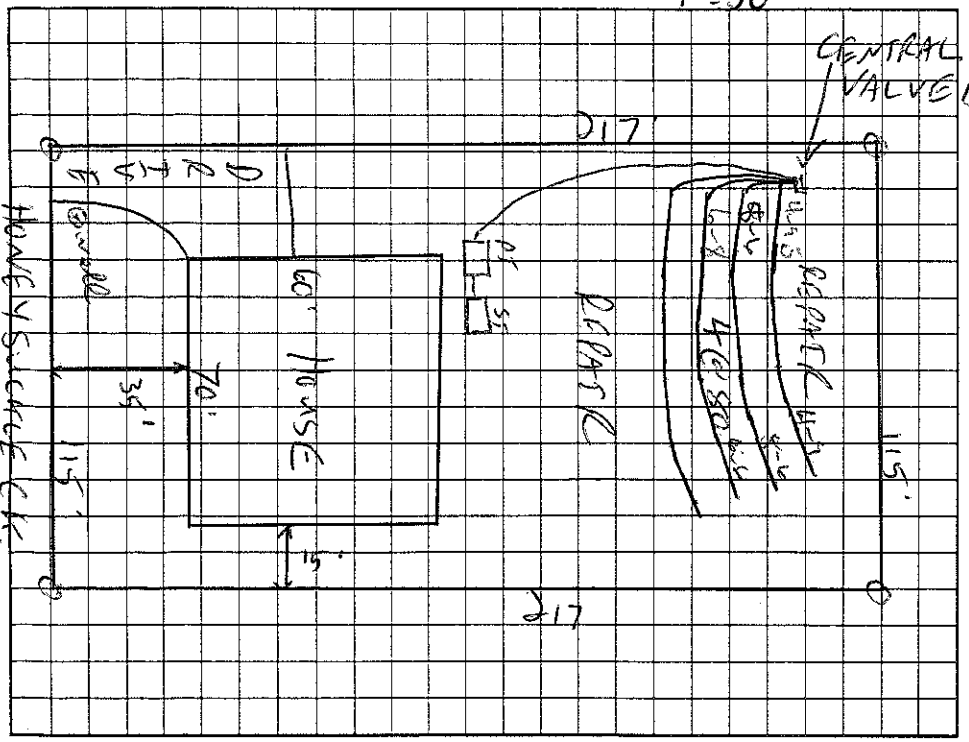

AS BUILT SKETCH

Permit can be suspended or revoked if any false information is supplied toward securing the permit/any unauthorized changes are made to the site/any unauthorized changes are made in the installation of the system. Improvement Permit with plat valid without expiration. Improvement Permit with site plan valid for sixty months. Authorization to Construct is valid for a period equal to that of Improvement Permit – not to exceed sixty months.

Signed: date 4-2-04 Installed by: C+S

Improvement Permit by: KS date 3/31/04 Operation Permit by: KS date 1/27/00

Authorization to Construct by: RS date 6/23/05 Existing System Inspection by: date

HEALTH DEPT. COPY: WHITE OWNER COPY (FINAL): YELLOW OWNER COPY (INITIAL): PINK