IREDELL COUNTY HEALTH DEPARTMENT

STATESVILLE 704-878-5305 MOORESVILLE 704-664-5281

IMPROVEMENT PERMIT / AUTHORIZATION TO CONSTRUCT / OPERATION PERMIT / EXISTING SYSTEM INSPECTION

PERMIT# 116 725 PIN# 4639 96 2769.15 4639-97-9157 DATE 11/28/05

OWNER OR APPLICANT Tagland - Brown Const PHONE: Business 704 507 5239 Home

ADDRESS 19559 Weavers Circle

LOCATION Perth (N), TL 2nd Honeysuckle on Rt

SUBDIVISION Honeysuckle Cove BLOCK / SECTION LOT 15 LOT AREA 0.62ac SITE CLASS. PS DESIGN FLOW 480 L.T.A.R. 0.25

Septic Tank: 1000 Gallons; STB 794 Date 10/6/05
Pump Tank: 1000 Gallons; PT 24 Date 10/19/05
Pump Make: Myers Model ME50 Serial No.
Nitrification Field: No Fields 1 Square Feet 640 Linear Feet 320
No Lines 6@54' Trench Width 24" Max Trench Bottom Depth 36" Gravel Depth — ☐ Gravity ☒ Pressure

☒ New System ☐ Repair ☐ Expansion System Type: I II III IV V VI
System Description: LP Panel Block
Repair System Description: Same
Maintenance Agreement Required: ☒ Yes ☐ No

☒ House/Mod. Home No. Bedrooms 4
☐ Mobile Home No. Persons
☐ Business No. Employees
☐ Other

Water Supply: ☒ Individual ☐ Public ☐ Community

☐ Slab ☒ Crawl Space ☐ Basement w/plumbing ☐ Basement wo/plumbing


Comments:/Conditions:

1" = 50'

Comments:/Conditions:

72 Panels 3/16" holes 43gpm

INITIAL SITE SKETCH

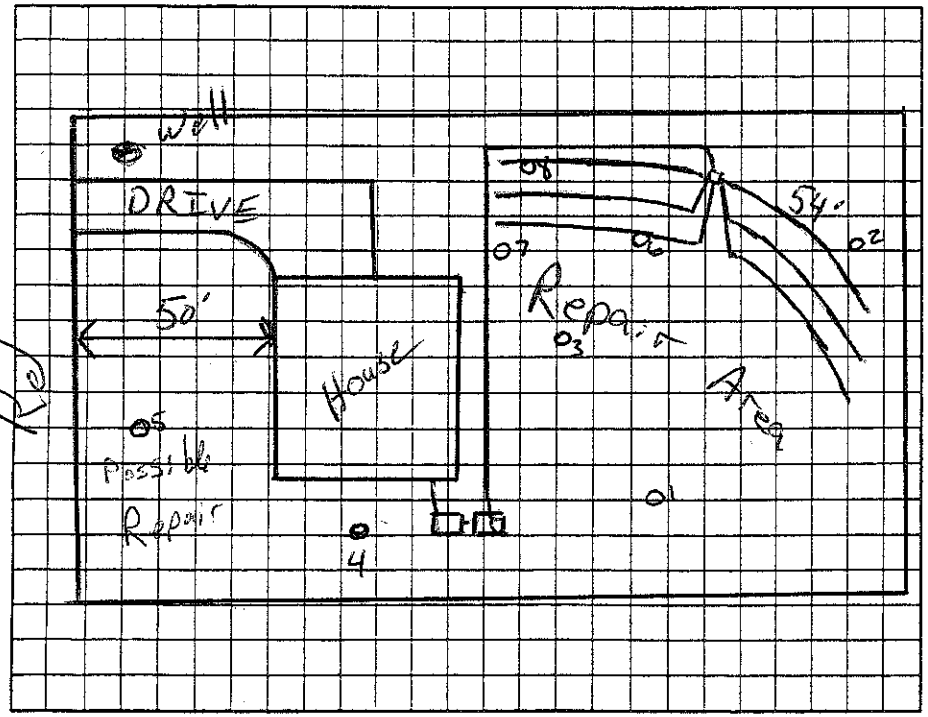

AS BUILT SKETCH

Permit can be suspended or revoked if any false information is supplied toward securing the permit/any unauthorized changes are made to the site/any unauthorized changes are made in the installation of the system. Improvement Permit with plat valid without expiration ☐ Improvement Permit with site plan valid for sixty months ☒ Authorization to Construct is valid for a period equal to that of Improvement Permit – not to exceed sixty months.

Signed: Wm Brown date 11/28/05 Installed by: Abernathy

Improvement Permit by: RS date 11/28/05 Operation Permit by: RS date 12/13/05

Authorization to Construct by: RS date 11/28/05 Existing System Inspection by: date

HEALTH DEPT. COPY: WHITE OWNER COPY (FINAL): YELLOW OWNER COPY (INITIAL): PINK