IREDELL COUNTY HEALTH DEPARTMENT

STATESVILLE 704-878-5305 MOORESVILLE 704-664-5281

IMPROVEMENT PERMIT / AUTHORIZATION TO CONSTRUCT / OPERATION PERMIT / EXISTING SYSTEM INSPECTION

PERMIT# 116707 PIN# 4639496276 9.12 4639-97-9291 DATE 3/30/04

OWNER OR CONTRACTOR HONEYSUCKLE CREEK LLC. / Rick Jones PHONE: Business 201-6465 Home

ADDRESS 227 HIDEAWAY LN. MOORESVILLE, NC 28117

LOCATION PERTH (N) - TL 2nd HONEYSUCKLE - 1st ON RT. CORNER

SUBDIVISION HONEYSUCKLE CK. BLOCK / SECTION LOT 12 LOT AREA .68Ac SITE CLASS. B5 DESIGN FLOW 360GPD L.T.A.R. .2650/FT2

Septic Tank: 1000 Gallons; STB 1612 Date 4/25/05
Pump Tank: 1000 Gallons; PT 17 Date 8/12/05
Pump Make: Goulds Model WE0-5F1H Serial No. J05L7662
Nitrification Field: No Fields 1 Square Feet 600 Linear Feet 300
No Lines 3@100' Trench Width 24" Max Trench Bottom Depth 36" Gravel Depth N/A

☑ New System ☐ Repair System Type: I, II, III, IV, V, VI
System Description: LP PANEL
Repair System Description: SAME
Maintenance Agreement Required: ☑ Yes ☐ No

☑ House/Mod. Home No. Bedrooms 3
☐ Mobile Home No. Bathrooms 3
☐ Business No. Employees
☐ Other


☐ Slab ☑ Crawl Space ☐ Basement w/plumbing ☐ Basement wo/plumbing

Water Supply: ☑ Individual ☐ Public ☐ Community

Comments:/Conditions: (DO NOT CUT HOUSE PAD) OK

Comments:/Conditions:

INITIAL SITE SKETCH 1" = 50'

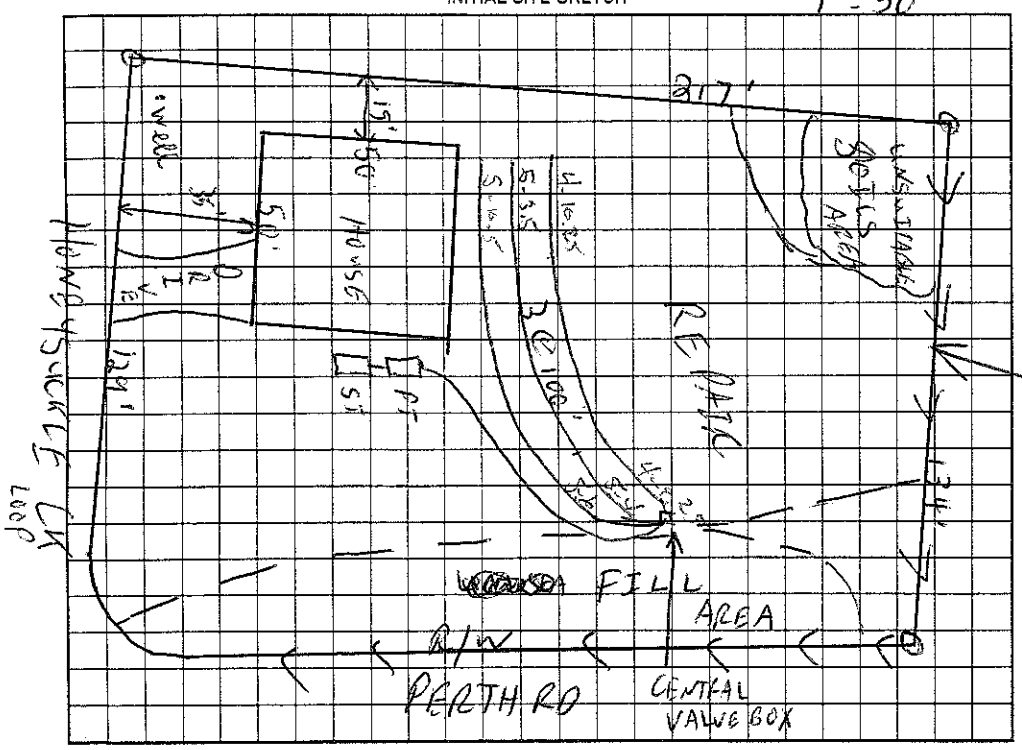

AS BUILT SKETCH

FRENCH DRAIN 48" DEEP ACROSS BACK PROPERTY LINE AND RAN OUT TO DAYLIGHT NEXT TO ROAD.

Permit can be suspended or revoked if any false information is supplied toward securing the permit/any unauthorized changes are made to the site/any unauthorized changes are made in the installation of the system. Improvement Permit with plat valid without expiration. Improvement Permit with site plan valid for sixty months. Authorization to Construct is valid for a period equal to that of Improvement Permit – not to exceed sixty months.

Signed: date 4-2-04 Installed by: C+S

Improvement Permit by: CS date 3/30/04 Operation Permit by: date 1/27/06

Authorization to Construct by: CS date 5/23/05 Existing System Inspection by: date

HEALTH DEPT. COPY: WHITE OWNER COPY (FINAL): YELLOW OWNER COPY (INITIAL): PINK