IREDELL COUNTY HEALTH DEPARTMENT

STATESVILLE 704-878-5305 MOORESVILLE 704-664-5281

IMPROVEMENT PERMIT / CERTIFICATE OF COMPLETION / OPERATION PERMIT / EXISTING SYSTEM INSPECTION

PROPERTY DESCRIPTION NO. 19785 DATE Dec 7, 94 TAX MAP NO. part of 2B132 Watershed: ☑ ~~Yes~~ ☐ No

OWNER OR CONTRACTOR Jerry Moss PHONE: Business _____ Home 662-6400 WS IV

ADDRESS PO Box 1370 / Cornelius

LOCATION 115 S. TR 1102 (LANGTREE) TR Knollview on Rt.

SUBDIVISION King's Landing BLOCK / SECTION _____ LOT 10 LOT AREA 35828 SITE CLASS 5 Spec 1956 DESIGN FLOW 480 gpd L.T.A.R. .3

Septic Tank: 1000 Gallons; STB 714 Delivered Date 2-13-95

Pump Tank: 1000 Gallons; PT 27 Delivered Date 3-30-95

Pump Make: _____ Model _____ Serial No. _____

Nitrification Field: No Fields 1 Square Feet _____ Linear Feet 540

No Lines 6 Trench Width 36" Max Trench Bottom Depth 30" Gravel Depth _____

☑ New System ☐ Repair System Type: I, II, (III), IV, V, VI

System Description: pump to pressure man. / conv.

Repair System Description: LP PRBPS

Maintenance Agreement Required: ☐ Yes ☑ No

☑ House/Mod. Home No. Bedrooms 4

☐ Mobile Home No. Bathrooms 3½

☐ Business No. Employees _____

☐ Other _____

☐ Slab ☑ Crawl Space ☐ Basement w/plumbing ☐ Basement wo/plumbing


Water Supply: ☐ Individual ☑ Community ☐ Public

Comments: Follow contour w/ laterals, SEE ME for details regarding pressure manifold and manifold box.


Comments:

1" = 40'

INITIAL SITE SKETCH

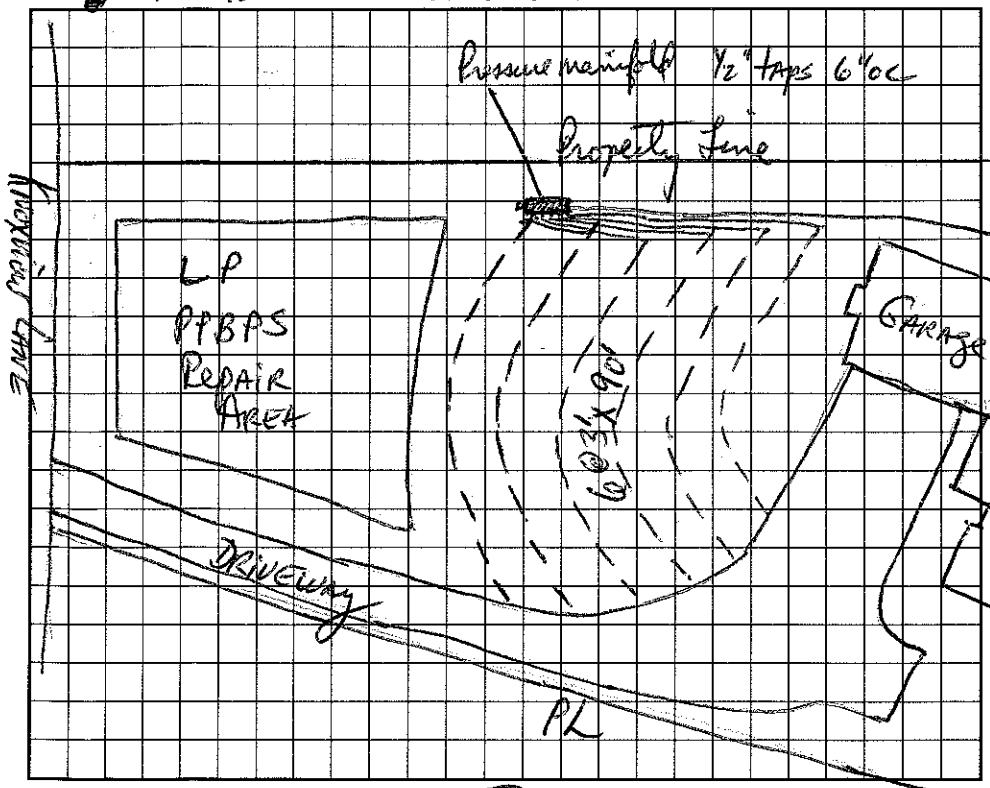

AS BUILT SKETCH

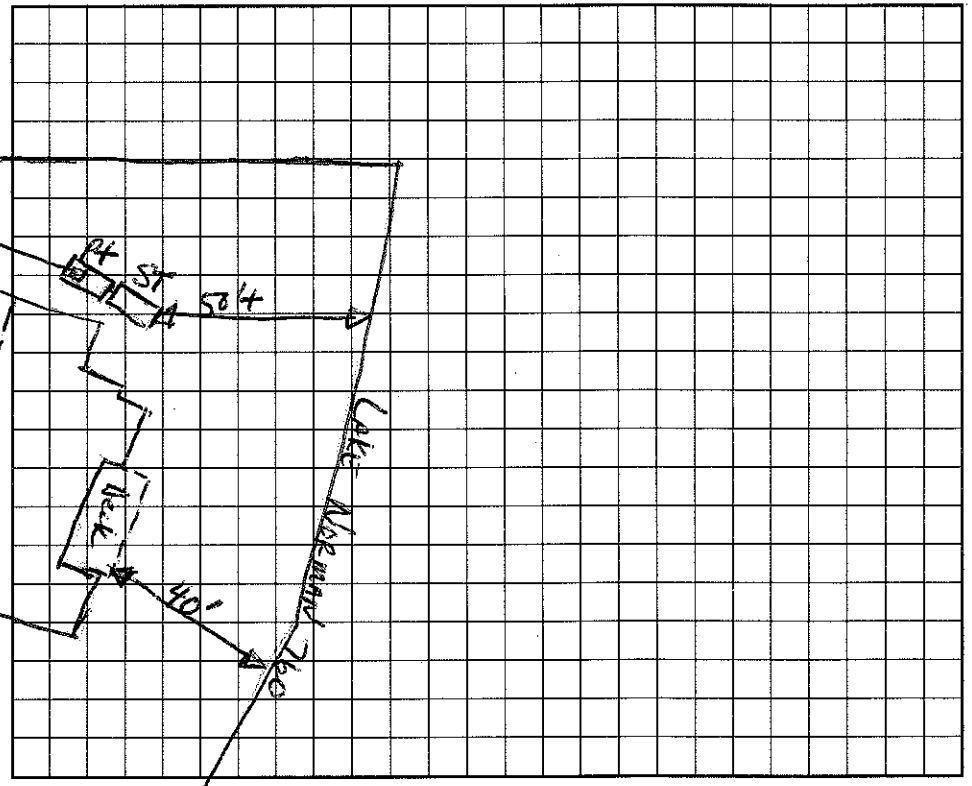

I understand that this permit can be ~~suspended~~ or revoked if any false information is supplied toward securing the permit/any unauthorized changes are made to the site/any unauthorized changes are made in the installation of the system. Improvement Permit is valid for 60 months from date of issuance.

Signed: _____

Improvement Permit by: _____ date 12/7/94

Existing System Inspection by: _____ date _____

Installed by: _____

Certificate of Completion by: _____ date _____

Operation Permit by: _____ date _____

HEALTH DEPT. COPY: WHITE INSPECTION COPY (FINAL): GREEN OWNER COPY (FINAL): YELLOW INSPECTION COPY (INITIAL): PINK OWNER COPY (INITIAL): GOLD