IREDELL COUNTY HEALTH DEPARTMENT

Authorization to Construct

STATESVILLE 704-878-5305 MOORESVILLE 704-664-5281

IMPROVEMENT PERMIT / CERTIFICATE OF COMPLETION / OPERATION PERMIT / EXISTING SYSTEM INSPECTION

PROPERTY DESCRIPTION NO. 65624 DATE 4/21/97 TAX MAP NO. 4644080890 Watershed: [X] Yes [ ] No

OWNER OR CONTRACTOR Thomas A. Hyatt PHONE: Business _____ Home 883-1001

ADDRESS 7604 Mariner Cove Dr. Cornelius, NC. 28031

LOCATION Langtree Rd. TL 2nd Knollview Ln. to 18th lot on (L) after Cortle Court

SUBDIVISION KINGS LANDING BLOCK / SECTION _____ LOT 63 LOT AREA .75 AC SITE CLASS PS DESIGN FLOW 480 L.T.A.R. .3

Septic Tank: 1000 Gallons; STB 312 Date 4/20/97
Pump Tank: 1000 Gallons; PT _____ Date _____
Pump Make: _____ Model _____ Serial No. _____
Nitrification Field: No Fields 1 Square Feet *1200 Linear Feet *400
No Lines *4 Trench Width 36" Max Trench Bottom Depth 36" Gravel Depth STAND.

[X] New System [ ] Repair System Type: I, II, III, IV, V, VI
System Description: Stan-Ch. Plastic
Repair System Description: Pres-Ch. Plastic
Maintenance Agreement Required: [ ] Yes [X] No


[X] House/Mod. Home No. Bedrooms 4
[ ] Mobile Home No. Bathrooms 3
[ ] Business No. Employees _____
[ ] Other _____
[ ] Slab [X] Crawl Space [ ] Basement w/plumbing [ ] Basement wo/plumbing

Water Supply: [ ] Individual [X] Community [ ] Public

Comments: * 25% REDUCTION FOR CH PLASTIC USE

Comments: 4 lines 100'x3' installed

INITIAL SITE SKETCH

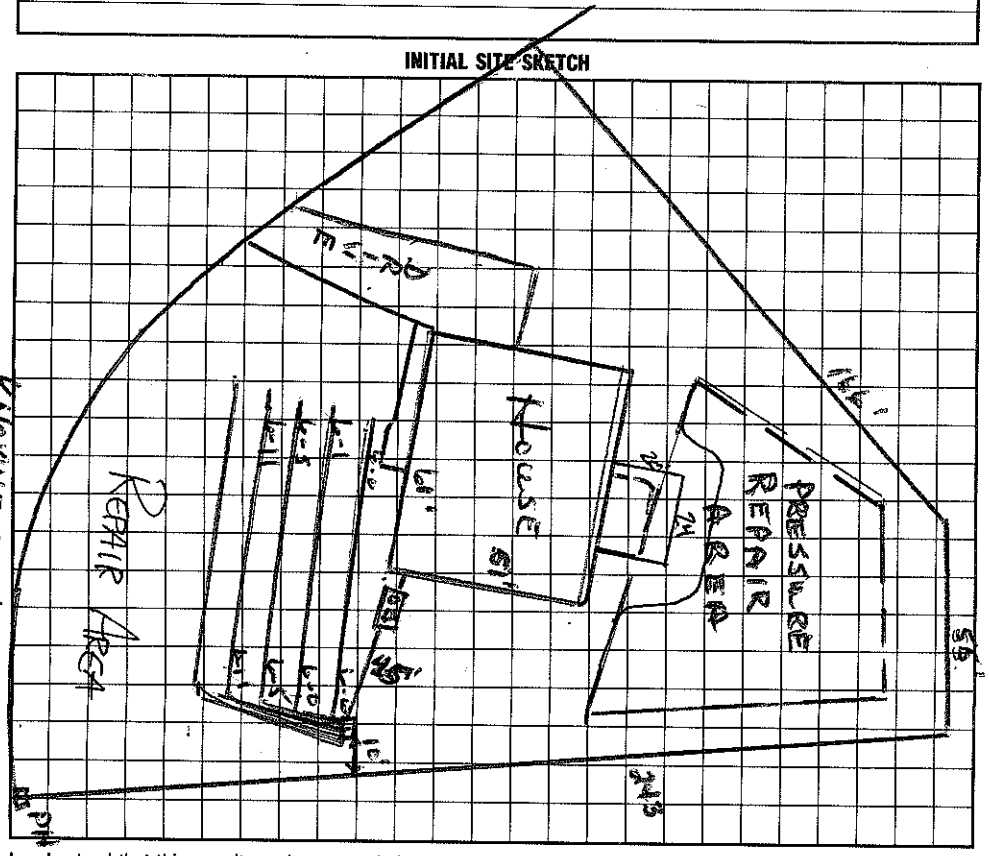

AS BUILT SKETCH

Location of the proposed PORCH addition does not appear to impact the existing on-site septic system.**NOTE: _____

Date: 1-4-11 REHS

ICHD-Environmental Health Division

I understand that this permit can be suspended or revoked if any false information is supplied toward securing the permit/any unauthorized changes are made to the site/any unauthorized changes are made in the installation of the system. Improvement Permit is valid for 60 months from date of issuance.

Signed: * Thomas A. Hyatt

Improvement Permit by: Wesley Sparks R.S. date 4/21/97

System Inspection by: Wesley Sparks R.S. date 4/21/97

Installed by: F.J. Ennis

Certificate of Completion by: Wesley Sparks R.S. date 7/30/99

Operation Permit by: Wesley Sparks R.S. date 7/30/99

HEALTH DEPT. COPY: WHITE INSPECTION COPY (FINAL): GREEN OWNER COPY (FINAL): YELLOW INSPECTION COPY (INITIAL): PINK OWNER COPY (INITIAL): GOLD