# IREDELL COUNTY HEALTH DEPARTMENT

STATESVILLE 704-878-5305 MOORESVILLE 704-664-5281

## IMPROVEMENT PERMIT / AUTHORIZATION TO CONSTRUCT / OPERATION PERMIT / EXISTING SYSTEM INSP

$7500 Fgid $.50

PERMIT# 70774 PIN# 4644080993 DATE 5/3/01

OWNER OR CONTRACTOR JIMMY MESSER PHONE: Business _____ Home _____

ADDRESS 137 AQUA DRIVE MOORESVILLE

LOCATION LANDTREE - TL 1ST KNOXVIEW - ON RT BEFORE CURVE

SUBDIVISION KENTS LANDING BLOCK / SECTION _____ LOT 64 LOT AREA _____ SITE CLASS. RS DESIGN FLOW 450GPD L.T.A.R. .30PD/FT2

Septic Tank: ~~1000~~ 1500 Gallons; STB 829 Date 7/2/01

Pump Tank: _____ Gallons; PT _____ Date _____

Pump Make: _____ Model _____ Serial No. _____

Nitrification Field: No Fields 1 Square Feet 1200 Linear Feet 402

No Lines 6 @ 67' Trench Width 36" Max Trench Bottom Depth 36" Gravel Depth N/A

☑ New System ☐ Repair System Type: I, II, III, IV, V, VI

System Description: GRAVITY 25% REDUCED

Repair System Description: PUMP SAVER

Maintenance Agreement Required: ☐ Yes ☑ No

☑ House/Mod. Home No. Bedrooms 4

☐ Mobile Home No. Bathrooms 4

☐ Business No. Employees _____

☐ Other _____


☐ Slab ☑ Crawl Space ☐ Basement w/plumbing ☐ Basement wo/plumbing

Water Supply: ☐ Individual ☐ Public ☑ Community


Comments:/Conditions:

Comments:/Conditions:

INITIAL SITE SKETCH

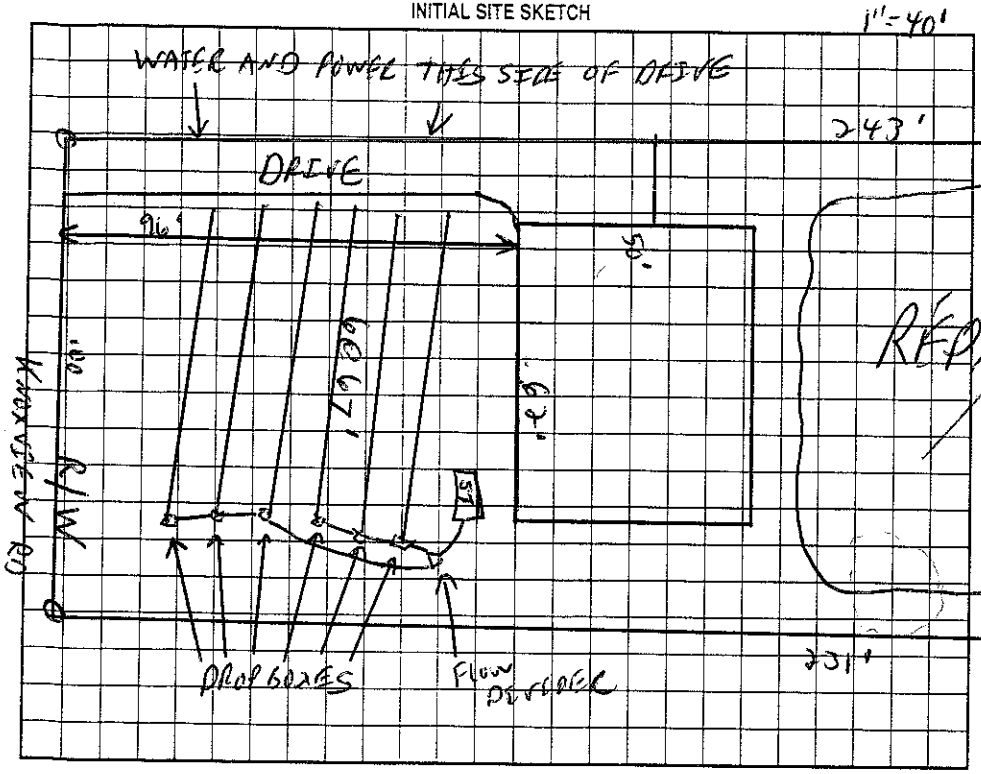


AS BUILT SKETCH

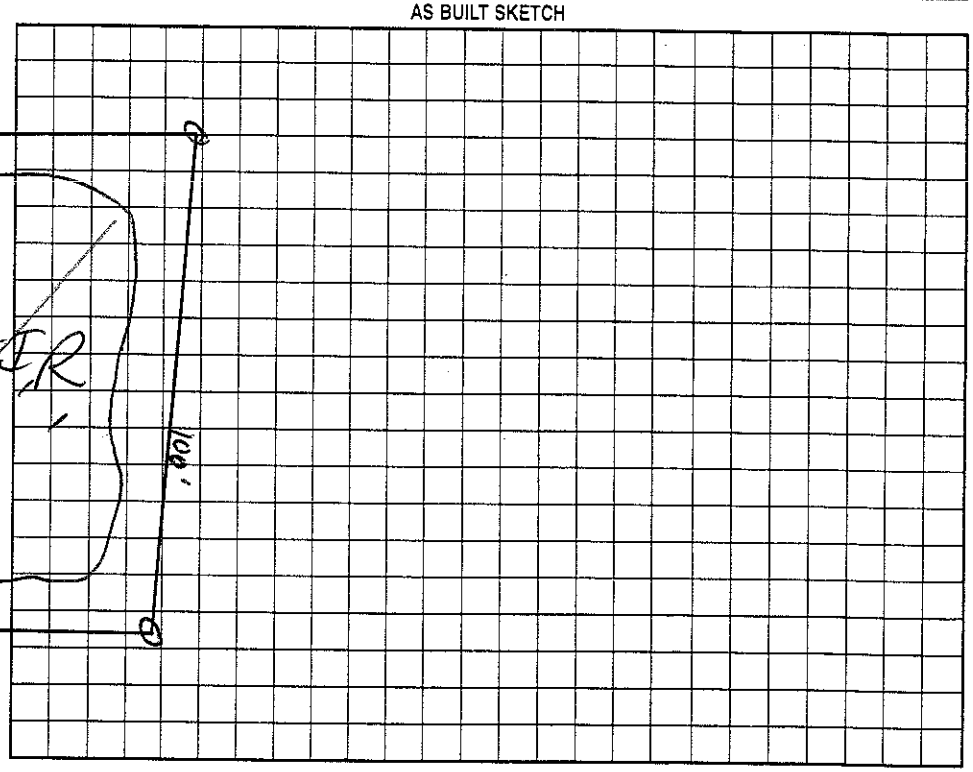


Permit can be suspended or revoked if any false information is supplied toward securing the permit/any unauthorized changes are made to the site/any unauthorized changes are made in the installation of the system. Improvement Permit with plat valid without expiration. Improvement Permit with site plan valid for sixty months. Authorization to Construct is valid for a period equal to that of Improvement Permit – not to exceed sixty months.

Signed: J. N. Mess date 5/8/01

Improvement Permit by: C. Ray Tenney LS date 5/3/01

Authorization to Construct by: C. Ray Tenney LS date 5/3/01

Installed by: A. Cornelius Grading

Operation Permit by: RSF date 8/21/01

Existing System Inspection by: _____ date _____

HEALTH DEPT. COPY: WHITE OWNER COPY (FINAL): YELLOW OWNER COPY (INITIAL): PINK