IREDELL COUNTY HEALTH DEPARTMENT

Authorization to Construct (1:30)

STATESVILLE 704-878-5305 MOORESVILLE 704-664-5281

IMPROVEMENT PERMIT / ~~CERTIFICATE OF COMPLETION~~ / OPERATION PERMIT / EXISTING SYSTEM INSPECTION

PROPERTY DESCRIPTION NO. 24421 DATE 7/19/96 TAX MAP NO. 2B 5B E 4644 08 1581 Watershed: X Yes ☐ No

OWNER OR CONTRACTOR CR Dobson Bldrs. (JP Rice) PHONE: Business 548-0067 Home

ADDRESS 8220 Univ. Exec. Pk. Char. NC. 28208

LOCATION Longtree Rd. TL 2nd Knockview Ln. 1st lot on (R) past boat slips

SUBDIVISION KINGSLNDG. BLOCK / SECTION MAP 2 LOT 8 LOT AREA 30,000 FT² SITE CLASS. PS DESIGN FLOW 480 L.T.A.R. .3

Septic Tank: 1000 Gallons; STB 714 Date 2/27/97

Pump Tank: 1000 Gallons; PT 27 Date 4/2/97

Pump Make: HYDRIMATIC Model SK50A1 Serial No. 394

Nitrification Field: No Fields 1 Square Feet 1600 Linear Feet ~~420~~

No Lines 6 Trench Width 36" Max Trench Bottom Depth 34" Gravel Depth SAND

X New System ☐ Repair System Type: I, II, III, IV, V, VI

System Description: Presson Chamber

Repair System Description: Same

Maintenance Agreement Required: ☐ Yes X No

X House/Mod. Home No. Bedrooms 4

☐ Mobile Home No. Bathrooms 3

☐ Business No. Employees

☐ Other


☐ Slab X Crawl Space ☐ Basement w/plumbing ☐ Basement wo/plumbing

Water Supply: ☐ Individual X Community ☐ Public


Comments: Sand backfill over louvers
~185GALS/DOSE / ~30GPM

Comments: PRESSURE, LINES, TANKS CHECKED 5/20/97

INITIAL SITE SKETCH

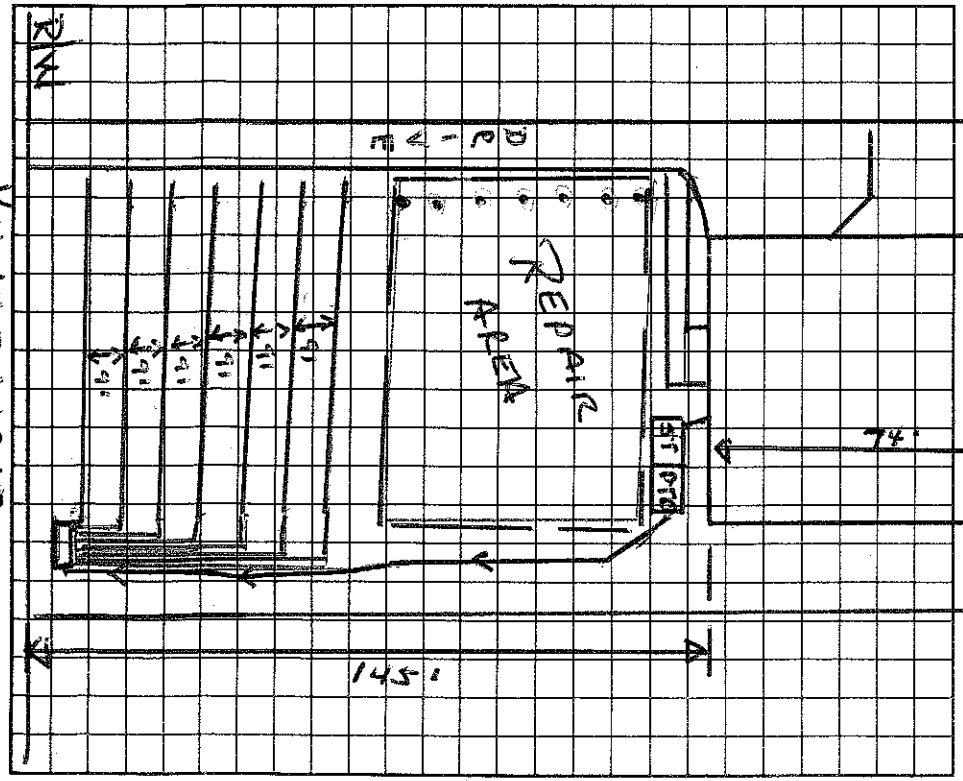

AS BUILT SKETCH

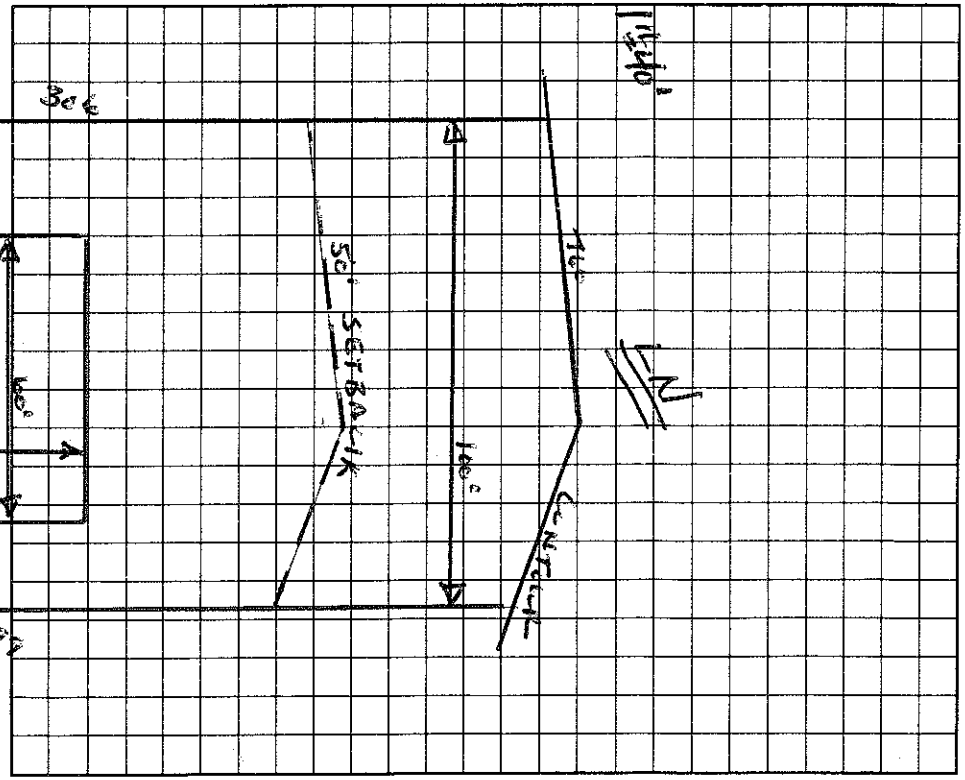

I understand that this permit can be suspended or revoked if any false information is supplied toward securing the permit/any unauthorized changes are made to the site/any unauthorized changes are made in the installation of the system.

Authorization to Construct indefinitely valid.

Signed: [signature]

Improvement Permit by: Wesley Sparks R.S. date 7/19/96

Existing System Inspection by: Wesley Sparks R.S. date 7/19/96

Installed by: MAHEW SEPTIC

Certificate of Completion by: date

Operation Permit by: [signature] date 7/15/97

HEALTH DEPT. COPY: WHITE INSPECTION COPY (FINAL): GREEN OWNER COPY (FINAL): YELLOW INSPECTION COPY (INITIAL): PINK OWNER COPY (INITIAL): GOLD