IREDELL COUNTY HEALTH DEPARTMENT

STATESVILLE 704-878-5305 MOORESVILLE 704-664-5281

IMPROVEMENT PERMIT / AUTHORIZATION TO CONSTRUCT / OPERATION PERMIT / EXISTING SYSTEM INSPECTION

PERMIT# 067484 PIN# 4644090072 DATE 7/13/98

OWNER OR CONTRACTOR James E. McKinney PHONE: Business Home 596-1597

ADDRESS 11309 Concessio Rd. Charlotte, NC. 28213

LOCATION Knoxville home - 1st Knoxville to 4th on (R) after old end de sac

SUBDIVISION Kingsbridge BLOCK / SECTION LOT 65 LOT AREA .54AC SITE CLASS. PS DESIGN FLOW L.T.A.R. .3

Septic Tank: 1000 Gallons; STB 799 Date 4/8/98

Pump Tank: ~~AWS~~ Gallons; PT Date

Pump Make: Model Serial No.

Nitrification Field: No Fields 1 Square Feet 1560 Linear Feet 520

No Lines 8 Trench Width 36" Max Trench Bottom Depth 36" Gravel Depth SAND

[X] New System [ ] Repair System Type: I, II, (III) IV, V, VI

System Description: FLOWDRIVER-D/Bio-CH PLUS PRESSURE

Repair System Description:

Maintenance Agreement Required: [ ] Yes [X] No

[X] House/Mod. Home No. Bedrooms 5

[ ] Mobile Home No. Bathrooms 3

[ ] Business No. Employees

[ ] Other


[ ] Slab [X] Crawl Space [ ] Basement w/plumbing [ ] Basement wo/plumbing

Water Supply: [ ] Individual [ ] Public [X] Community

Comments:/Conditions:


Comments:/Conditions:

INITIAL SITE SKETCH

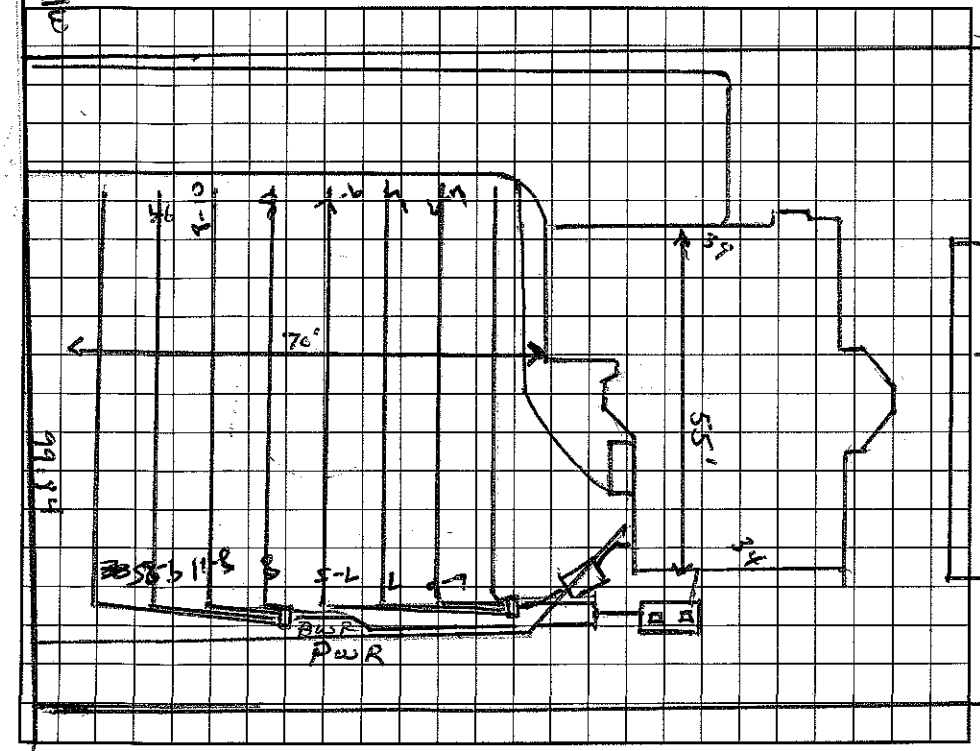

1" = 30'

AS BUILT SKETCH

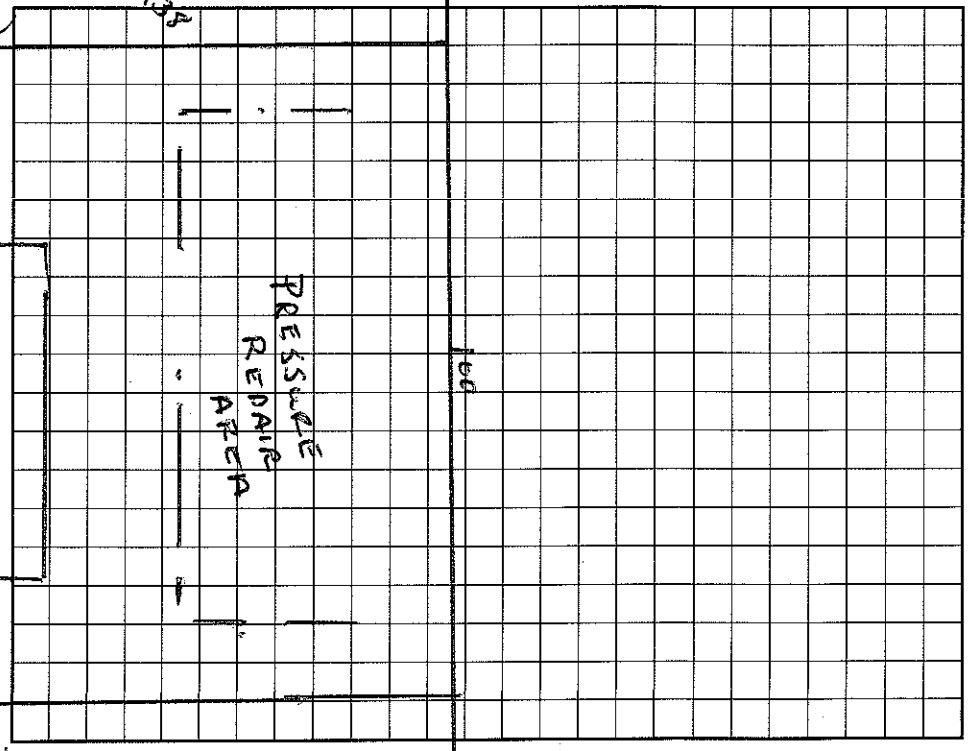

I understand that this permit can be suspended or revoked if any false information is supplied toward securing the permit/any unauthorized changes are made to the site/any unauthorized changes are made in the installation of the system. Improvement Permit with plat valid without expiration. Improvement Permit with site plan valid for sixty months. Authorization to Construct is valid for a period equal to that of Improvement Permit – not to exceed sixty months.

Signed: [signature] 7/14/98 date

Improvement Permit by: Wesley Sparks RS. date 7/13/98

Authorization to Construct by: Wesley Sparks RS date 7/13/98

Installed by: Bob Mayhew

Operation Permit by: Wesley Sparks RS. date 7/20/98

Existing System Inspection by: Wesley Sparks date 7/20/98

HEALTH DEPT. COPY: WHITE INSPECTION COPY (FINAL): GREEN OWNER COPY (FINAL): YELLOW INSPECTION COPY (INITIAL): PINK OWNER COPY (INITIAL): GOLD