IREDELL COUNTY HEALTH DEPARTMENT

Authorization to Construct

STATESVILLE 704-878-5305 MOORESVILLE 704-664-5281

IMPROVEMENT PERMIT / ~~CERTIFICATE OF COMPLETION~~ / OPERATION PERMIT / EXISTING SYSTEM INSPECTION

PROPERTY DESCRIPTION NO. 069105 DATE 9/24/97 TAX MAP NO. 4644090253 Watershed: X Yes ☐ No

OWNER OR CONTRACTOR James Dickinson PHONE: Business Home 662-8778

ADDRESS 104 Pen 33 Dr. 317 Mooresville, NC. 28115

LOCATION 180 Knollview Ln. - Langtree Rd, TL first Knollview to 14th lot on (R) 360

SUBDIVISION Kimp Lending BLOCK / SECTION LOT 67 LOT AREA .56 SITE CLASS. PS DESIGN FLOW ~~460~~ L.T.A.R. .3

Septic Tank: 1000 Gallons; STB 794 Date 9/2/98

Pump Tank: Gallons; PT Date Aug

Pump Make: S Model Serial No. 3cc

Nitrification Field: No Fields 1 Square Feet 1200 ✓ Linear Feet ~~460~~

No Lines X 4 Trench Width 36" Max Trench Bottom Depth 36" Gravel Depth SAND

X New System ☐ Repair System Type: I, II, (III) IV, V, VI

System Description: GRAVITY - CHPLASTIC ORHDS

Repair System Description: SAME

Maintenance Agreement Required: ☐ Yes X No

X House/Mod. Home No. Bedrooms 3 4

☐ Mobile Home No. Bathrooms 3

☐ Business No. Employees

☐ Other


☐ Slab X Crawl Space ☐ Basement w/plumbing ☐ Basement wo/plumbing

Water Supply: ☐ Individual X Community ☐ Public


Comments: 11/20/98 Changed to 380 Rm - INSTALL 300' CH. Plastic - 4@ 75'x3'

Comments:

INITIAL SITE SKETCH

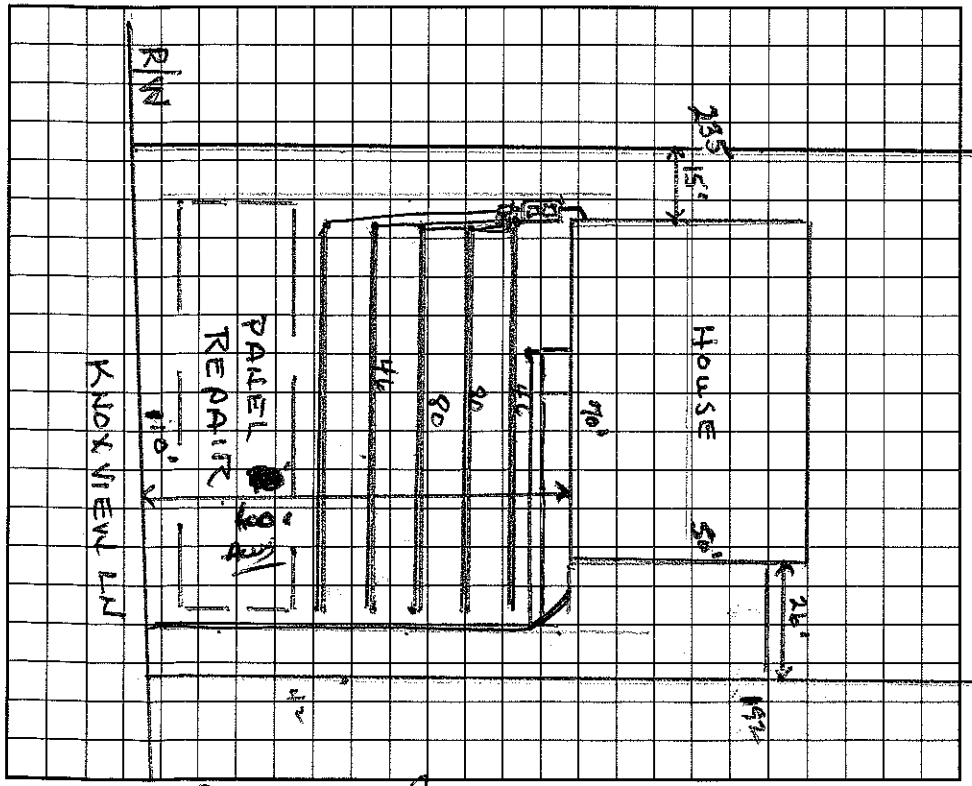

AS BUILT SKETCH

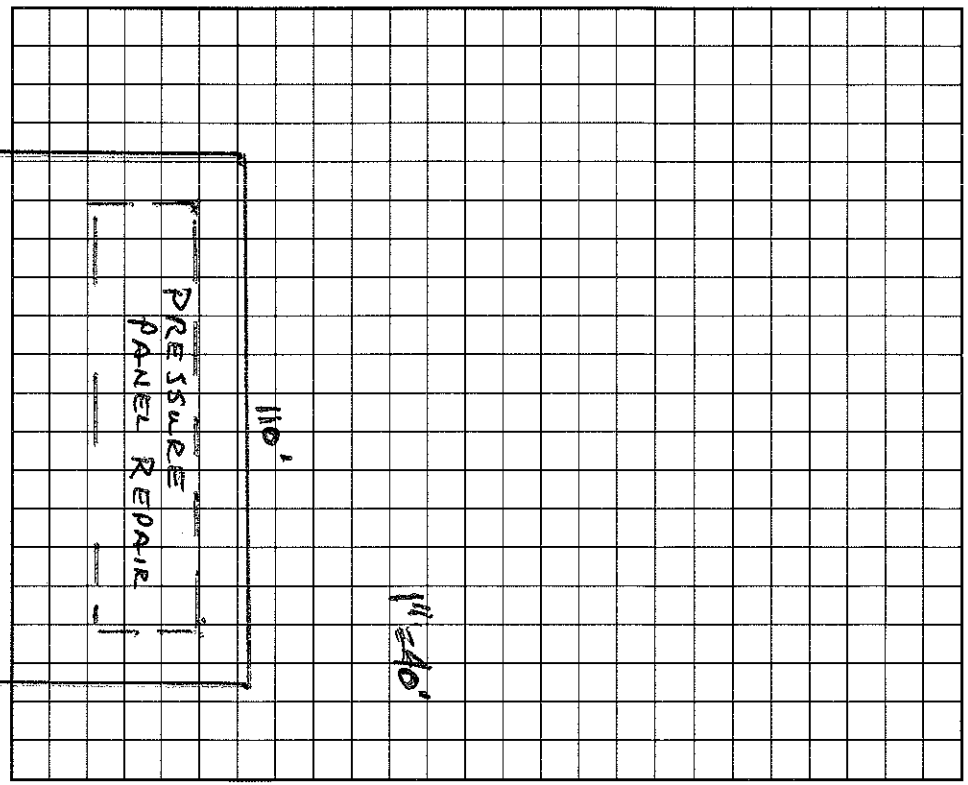

I understand that this permit can be suspended or revoked if any false information is supplied toward securing the permit/any unauthorized changes are made to the site/any unauthorized changes are made in the installation of the system. Improvement Permit is valid for 60 months from date of issuance.

Signed: Karen K Wagg

Improvement Permit by: Wesley Sparks R.S. date 9/24/97

~~Authorization~~ Existing System Inspection by: Wesley Sparks R.S. date 9/24/97

Installed by: Dave Clark

Certificate of Completion by: Wesley Sparks R.S. date 12/3/98

Operation Permit by: date

HEALTH DEPT. COPY: WHITE INSPECTION COPY (FINAL): GREEN OWNER COPY (FINAL): YELLOW INSPECTION COPY (INITIAL): PINK OWNER COPY (INITIAL): GOLD